

CAPE CANAVERAL AIR FORCE STATION,
LAUNCH COMPLEX 39,
HYPERGOL MAINTENANCE AND CHECKOUT AREA,
HYPERGOL MODULE PROCESSING NORTH
(HMP North)
(John F. Kennedy Space Center)
Cape Canaveral
Brevard County
Florida

HAER FL-8-11-T-1

PHOTOGRAPHS

WRITTEN HISTORICAL AND DESCRIPTIVE DATA

Historic American Engineering Record
National Park Service
Department of the Interior
100 Alabama St., SW
Atlanta, GA 30303

HISTORIC AMERICAN ENGINEERING RECORD
CAPE CANAVERAL AIR FORCE STATION, LAUNCH COMPLEX 39
HYPERGOL MAINTENANCE AND CHECKOUT AREA,
(HMCA Complex)
HYPERGOL MODULE PROCESSING NORTH,
(HMP North)

HAER No. FL-8-11-T-1

Location: John F. Kennedy Space Center, Industrial Area, Brevard
County, Florida.

USGS Orsino, Florida, Quadrangle, Universal Transverse
Mercator Coordinates: E 535140 N 3154380 Zone 17, NAD
1983.

Date of Construction: 1964

Present Owner: National Aeronautics and Space Administration
(NASA)

Present Use: Not in use

Significance: The Hypergol Module Processing North (HMP North) (M7-961) is eligible to the National Register of Historic Places in the context of the U.S. Space Shuttle Program (SSP) (1969-2011) under Criterion A for its significant associations in the area of Space Exploration. Since it has achieved exceptional national significance in the last 50 years, Criteria Consideration G applies. HMP North was built in 1964 as part of what was originally called the Fluid Test Complex, now called the Hypergol Maintenance and Checkout Area (HMCA Complex). Originally called the Environmental Systems Test Building, HMP North's refurbished the Space Shuttle's Forward Reaction Control System (FRCS) and Orbital Maneuvering System (OMS) pods, performed hypergolic test loading, and hazardous systems tests and checkouts.

Report Prepared By: New South Associates, Stone Mountain, Georgia

Date: March 14, 2013

Part I. HISTORICAL INFORMATION

List of Acronyms

APU	Auxiliary Power Units
CIF	Central Instrumentation Facility
EST	Environmental Systems Test Building
FRCS	Forward Reaction Control System
HAER	Historic American Engineering Record
He	Helium
HMCA	Hypergol Maintenance and Checkout Area
HMP	Hypergol Module Processing
KSC	Kennedy Space Center
LCC	Launch Control Center
LH ₂	Liquid Hydrogen
LO ₂	Liquid Oxygen
LRU	Line Replaceable Units
MMH	Monomethyl Hydrazine
NASA	National Aeronautics and Space Administration
GN ₂	Gaseous Nitrogen
N ₂ O ₄	Nitrogen Tetroxide
O&C	Operations & Checkout
OMS	Orbital Maneuvering System
OPF	Orbiter Processing Facility
PRF	Parachute Refurbishment Facility
SCAPE	Self Contained Atmospheric Protective Ensemble
SSP	Space Shuttle Program
TPS	Thermal Protection System
VAB	Vehicle Assembly Building

A. HMP North and the Space Shuttle Program

HMP North was built in 1964 and was originally called the Environmental Systems Test Building (EST). It contained test equipment for spacecraft environmental control, or life support, systems. The facility had two 40' square by 60' high test cells on opposite sides of a central building

CAPE CANAVERAL AIR FORCE STATION, LAUNCH COMPLEX 39,
HYPERGOL MAINTENANCE AND CHECKOUT AREA,
HYPERGOL MODULE PROCESSING NORTH
HAER NO. FL-8-11-T-1

PAGE 3

that contained control rooms on the second floor and equipment storage rooms on the first floor. Each test cell had overhead cranes with hook heights of 45'. There were also pre-installation acceptance laboratories for the validation of spacecraft components on the first floor.¹

To support the SSP, the Fluid Test Complex facilities were modified in 1976 by Pan American Technical Services, Inc., of Cocoa Beach, Florida. At this time the name of the complex was changed to the Hypergol Maintenance and Checkout Area and the Environmental Systems Test Building's name was changed to HMP North (M7-961). Changes were made to the interiors of the buildings in the area, especially in the high bay work areas, to refurbish and checkout the Space Shuttle's Forward Reaction Control System (FRCS), aft Orbital Maneuvering Systems (OMS) pods, hypergolic systems, and other hazardous systems tests and checkouts.

Specifically, HMP North was modified to refurbish and checkout the hypergolic fuel modules of the Space Shuttle orbiter's aft OMS pods.² The OMS pods were attached to either side of the orbiter's upper aft fuselage, and each pod was divided into two compartments containing the OMS engines.³

The RCS and OMS systems worked in tandem on the orbiter to provide thrust for orbital maneuvers and small axis changes. Each RCS contained high-pressure gaseous helium storage tanks, pressure regulation and relief systems, hypergolic fuel and oxidizer tanks, an engine propellant

¹ Pan American World Airways, Inc., "Analytical Report, John F. Kennedy Space Center, NASA, Kennedy Space Center, Florida - Master Plan." (KSC Master Planning Office, 1965), 33.

² For an explanation of hypergolic propellants as they relate to the SSP, see: HAER No. FL-8-11-T, page 4.

³ NASA, "Reaction Control System," NSTS Shuttle Reference Manual, 1988, <http://science.ksc.nasa.gov/shuttle/technology/sts-newsref/sts-rcs.html>.

distribution system, and thermal control systems. The RCS rockets and thrusters provided thrust for attitude (rotational) maneuvers, including pitch, yaw, and roll, and for small velocity changes along the orbiter's axis. Each OMS contained one engine and the hardware needed to pressurize, store, and distribute the hypergolic propellants and oxidizers needed to perform maneuvers. The OMS engines provided thrust for orbit insertion, orbit circularization, orbit transfer, rendezvous, deorbit, and other orbital maneuvers.⁴ When the Space Shuttle was docked at the International Space Station (ISS), the OMS engines could be used to push the ISS into a higher orbit.⁵

HMP North continued to service the orbiter's aft RCS and OMS pods through the end of the SSP. The program ended in July of 2011, when the crew of *Atlantis* landed at KSC to complete the program's 135th mission (STS-135). Since the SSP's first launch in 1981, the program launched 355 astronauts from 16 countries. The five shuttles traveled more than 542 million miles and conducted over 2,000 experiments in the fields of Earth, astronomy, biological, and materials sciences. The shuttles docked with two space stations, including the Russian *Mir* and the International Space Station, and deployed 180 payloads such as satellites and spacecraft. With the return of the final mission, NASA Administrator Charles Bolden said, "the brave astronauts of STS-135 are emblematic of the shuttle program - skilled professionals from diverse backgrounds who propelled America to continued leadership in space with the shuttle's many successes."⁶

⁴ Ibid.

⁵ Larry Taylor, URS Facilities Manager, interview with author, April 8, 2013.

⁶ Michael Curie, Kyle Herring, and Candrea Thomas, "NASA's Proud Space Shuttle Program Ends With Atlantis Landing," NASA press

D. Physical History

1. Date of Construction:

1964

2. Architect/Engineer:

Tampa Bay Engineering Company, St. Petersburg, Florida⁷

3. Builder/Contractor/Supplier:

Not known

4. Original Plan and Construction:

HMP North was built in two consecutive phases. The first phase was the construction of the building's main portion, including two 40' square by 60' high test cells on opposite sides of a two-story central building. The central building contained control rooms on the second floor that operated equipment used in the test cells. The first floor contained two equipment storage rooms, two locker rooms, an office, a mechanical room, and two pre-installation acceptance laboratories for the validation of spacecraft environmental systems components. The test cells had segmented vertical-lift doors on their east and west elevations, and each cell had an overhead crane with a hook height of 45'. The building had a reinforced

release, http://www.nasa.gov/home/hqnews/2011/jul/HQ_11-240_Atlantis_Lands.html, accessed on March 8, 2012.

⁷ Tampa Bay Engineering Company, "Fluid Test Complex, Environmental Control Systems Building," construction drawings, March 5, 1963.

concrete frame structure, concrete block walls, and steel high bay doors.⁸

The second phase of construction occurred immediately after the first and included a one-story, 3,000-square foot addition to the building's south elevation. The addition had a reinforced concrete frame structure, concrete block walls, and a gently sloping built-up flat roof. Its floor plan contained eight work rooms, a locker room/toilet, and a central corridor. The work rooms included two pre-installation acceptance rooms for coolant systems, one pre-installation acceptance room for water systems, two parts storage/tool crib rooms, a blacklight inspection room, a mechanical equipment room, and an equipment maintenance room.⁹

5. Additions and Alterations

HMP North was modified for the SSP in 1976. The modifications included the building's civil, architectural, structural, mechanical, and electrical systems. Civil site alterations to HMP North included new asphalt pavement, curbs and gutters, drainage grates, storm drains, and site contouring. Architectural changes included partition removal and modification of the original second-floor control rooms, entrance door replacements, new roofing, and a new roof penetration plan to accommodate new ventilation equipment. Structural changes included the installation of new fixed and hinged test stands in each of the building's test cells, which were used to service the shuttle's OMS and

⁸ Ibid.

⁹ NASA, "Addition to Manned Spacecraft Environmental Control Systems Building," construction drawings, August 1964.

CAPE CANAVERAL AIR FORCE STATION, LAUNCH COMPLEX 39,
HYPERGOL MAINTENANCE AND CHECKOUT AREA,
HYPERGOL MODULE PROCESSING NORTH
HAER NO. FL-8-11-T-1
PAGE 7

RCS systems. Various mechanical and electrical systems were also changed and upgraded throughout the facility.¹⁰

¹⁰ Pan American Technical Services, Inc., "Fluid Test Complex, Modifications for Shuttle," construction drawings, January 1976.

Part II. Structural/Design/Equipment Information

A. General Statement:

1. Character:

HMP North was originally used to process and checkout the environmental, or life support, systems of the Gemini and Apollo spacecraft. It was later modified to process and checkout the Space Shuttle's aft RCS and OMS pods. The concrete-frame and concrete-block building has a pair of high bay work cells on either side of a two-story central building, which contains control rooms and support areas. There is a one-story wing on the south elevation of the building that contains offices, labs, and storage areas.

2. Condition of Fabric:

The condition of HMP North's fabric is good. The building was regularly maintained throughout its lifespan. It does exhibit minor signs of deterioration such as peeling paint and rust.

B. Descriptions of Interior and Exterior:

HMP North is a spacecraft test facility with a reinforced concrete frame structure, painted 12" nominal concrete block walls, a reinforced concrete foundation, and a gently sloping built-up roof. The building has an irregular footprint and has overall dimensions of 128'-0" long (north-south) and 110'-0" wide (east-west). The building contains 7,600 square feet. The defining features of the building are two high-bay test cells with exterior dimensions of 40'-0" wide x 40'-0" long x 60'-0" high. The test cells are arranged on the east and west sides of a central two-story building that measures 30'-0" wide x 40'-0" long.

CAPE CANAVERAL AIR FORCE STATION, LAUNCH COMPLEX 39,
HYPERGOL MAINTENANCE AND CHECKOUT AREA,
HYPERGOL MODULE PROCESSING NORTH
HAER NO. FL-8-11-T-1
PAGE 9

There is a central, one-story projection on the north elevation that measures 30'-0" wide x 13'-0" deep. There is also a one-story concrete-block wing on the south elevation of the building that measures 68'-0" long x 48'-0" wide. The wing has a gently sloping built-up roof and a concrete foundation.

Each test cell features an exterior vertical-lift door that measures 22'-0" wide x 40'-0" high. The doors are equipped with inflatable seals that exclude contaminants and seal the building in case of toxic spills. Other entrances include a number of single and double pedestrian doors on all elevations. There are no windows on the building.

The test cells are equipped with large capacity exhaust systems designed to reduce contaminants and remove toxic fumes from the interior. A large array of ventilation equipment is located on top of the building's two-story portion, between the two test cells' exterior walls.

Arrayed around the building are a variety of chemical storage tanks, control panels, valves, and pipes that serve the interior testing areas. Just north of the east test cell is a monomethyl hydrazine (MMH) fuel pump and storage tank. Likewise, there is a nitrogen tetroxide (N_2O_4) tank on the north side of the west test cell. On the south side of the building are four storage tanks that contain gaseous helium and gaseous nitrogen.

The interior dimensions of HMP North's two test cells contain 38'-0" x 38'-0" of work space. This space includes service areas that checked out the hypergolic fuel and oxidizer systems used in the Space Shuttle orbiter's aft RCS and OMS pods. Each test cell contains four levels of stationary work platforms arranged in a U-shape around

CAPE CANAVERAL AIR FORCE STATION, LAUNCH COMPLEX 39,
HYPERGOL MAINTENANCE AND CHECKOUT AREA,
HYPERGOL MODULE PROCESSING NORTH
HAER NO. FL-8-11-T-1

PAGE 10

their interior walls. These work levels are spaced at 12'-0", 19'-0", 27'-0", and 35'-0" above the finished concrete floor. Steel staircases lead from one platform to the next. At the 12'-0", 19'-0", and 27'-0" levels there are hinged platforms that were lowered into place around the aft RCS and OMS modules after they were maneuvered into place. The modules were maneuvered with an overhead 10-ton hydraulic bridge crane with a hook height of 45'.

The interior of the central building's first floor contains storage rooms, a break room/kitchen, restroom, a power supply monitor room, lockers, and a gaseous helium/gaseous nitrogen regulator room filled with equipment panels. There is a metal spiral staircase that leads to the second floor. Interior finish materials include suspended acoustic tile ceilings, tile floors, and a combination of drywall and concrete block walls.

The interior of the central building's second floor contains the Hardware Interface Module (HIM) room, which was originally a control room for the test cells. The HIM room contains cabinets of computer equipment that control the hardware used in the test cells. This room has a raised floor that can be opened to reach the HIM cables and connectors that run under it.

C. Operations and Process

The operations at HMP North included the refurbishment disassembly/assembly, testing, propellant loading, and pressurization of hypergolic fuel and oxidizer lines of the Space Shuttle orbiter's aft OMS pods, RCS modules, and auxiliary power units (APUs). The building also houses the Quick Disconnect Laboratory, equipped to service the fuel and oxidizer Quick Disconnect lines used on the components, and the Thruster Bench Test Lab where OMS/RCS thrusters were refurbished.¹¹

The RCS/OMS pods were moved into the building's test cells through the vertical lift doors. The module on the left (port) side of the orbiter was processed in the west test cell, and the right (starboard) module was processed in the east test cell.

Once inside the building and raised into position, the hinged work platforms were lowered into place to allow access to the modules. Each component underwent an inspection and hookup of electrical testing cables and propellant lines. The components' thrusters were removed and inspected. The thrusters' regulators and valves were replaced if needed. Residual hypergolic propellants were drained and the systems were flushed and dried. All of the modules' line replaceable units (LRUs) were repaired or replaced, followed by an electrical and pneumatic checkout. The facility also inspected and repaired the electrical and Thermal Protection Systems (TPS) on the modules.¹²

Depending on launch and regular orbiter maintenance down periods, the OMS and RCS module process time varied from

¹¹ Sciarini and Tzareff, "Hypergol Maintenance Facility - North Area," 2004, 3.

¹² Slovinac and Deming, "Hypergolic Maintenance and Checkout Area Historic District," 2007; Stan D. Johnson, Senior Systems Technician, interview with author, April 9, 2012.

one to six months. Once the systems were revalidated and in proper working order, they were closed out and removed from the test cells and transported to the Orbiter Processing Facility (OPF) for installation.¹³

At the height of the SSP the number of technicians working in HMP North varied from 15-20.¹⁴ The hazardous nature of the toxic hypergolic fuels used in the modules required that technicians wear full-body self-contained atmospheric protective ensemble (SCAPE) suits, and vapor concentration monitors were used throughout the building.

Part III. Sources of Information

A. Primary Sources

Pan American World Airways, Inc.

1965 "Analytical Report, John F. Kennedy Space Center, NASA, Kennedy Space Center, Florida - Master Plan." On file in the KSC Master Planning Office.

B. Secondary Sources

Deming, Joan, and Patricia Slovinac

2007 "Hypergolic Maintenance & Checkout Area Historic District." National Register of Historic Places, draft nomination. On file at the Kennedy Space Center Cultural Resources Management Office.

2008 *NASA-Wide Survey and Evaluation of Historic Facilities in the Context of the U.S. Space Shuttle Program: Roll-Up Report*. Submitted to the National Aeronautics and Space Administration, Environmental Management

¹³ Slovinac and Deming, "Hypergolic Maintenance and Checkout Area Historic District," 2007; Johnson, interview with author, 2012.

¹⁴ Johnson, interview with author, 2012.

Branch. Sarasota, Florida: Archaeological
Consultants, Inc. February 2008, revised July 2008.

National Aeronautics and Space Administration [NASA]

1964 "Master Plan." On file in the KSC Master Planning
Office.

1984 "Space Transportation System: Facilities and
Operations, Kennedy Space Center, FL." On file at the
Kennedy Space Center Archives.

1988 "Reaction Control System," NSTS Shuttle Reference Manual,
[http://science.ksc.nasa.gov/shuttle/technology/sts-
newsref/sts-rcs.html](http://science.ksc.nasa.gov/shuttle/technology/sts-newsref/sts-rcs.html). Accessed March 8, 2012.

2002 NASA *Facts Online: Propellants - Hypergolic*,
[http://www-
pao.ksc.nasa.gov/nasafact/count2.htm#hypergol](http://www-pao.ksc.nasa.gov/nasafact/count2.htm#hypergol).
Accessed August 6, 2012.

Sciarini, E. Daniel, and Susan S. Tzareff

2004 "Hypergol Maintenance Facility - North Area (HMP
North) (M7-961), Kennedy Space Center, Florida, Solid
Waste Management Unit (SWMU) Assessment Report, PRL
#118 (Revision 0) [KSC-TA-7110]. J-BOSC Environmental
Health and Services, Environmental Compliance and
Public Health Section, Kennedy Space Center.

C. Engineering Drawings and Plans

Tampa Bay Engineering Co.

1963 "NASA Merritt Island Launch Area, Merritt Island,
FLA., Fluid Test Complex - Environmental Control
Systems Bldg." Construction Drawings.

"NASA Merritt Island Launch Area, Merritt Island,
FLA., Addition to Manned Spacecraft Environmental
Control Systems Building." Construction Drawings.

D. Early Views

Kennedy Space Center. Photograph negative number LOC-63-7252, dated 1963. On file at Kennedy Space Center Archives.

Kennedy Space Center. Photograph negative number LOC-63-8565, dated 1963. On file at Kennedy Space Center Archives.

Kennedy Space Center. Photograph negative number LOC-63-9100, dated 1963. On file at Kennedy Space Center Archives.

Kennedy Space Center. Photograph negative number 100-KSC-64C-2626, dated 1964. On file at Kennedy Space Center Archives.

Kennedy Space Center. Photograph negative number KSC-64C-0037, dated 1964. On file at Kennedy Space Center Archives.

Kennedy Space Center. Photograph negative number 100-KSC-65C-8832, dated 1965. On file at Kennedy Space Center Archives.

Kennedy Space Center. Photograph negative number 107-KSC-72-338, dated 1972. On file at Kennedy Space Center Archives.

Kennedy Space Center. Photograph negative number KSC-396C-0940-10, dated 1996. On file at Kennedy Space Center Archives.

Kennedy Space Center. Photograph negative number KSC-396C0947-36, dated 1996. On file at Kennedy Space Center Archives.

E. Interviews


Johnson, Stanley D.

2012 United Space Alliance. Senior Systems Technician. Interview with author.

Taylor, Larry

2013 URS Facilities Manager. Interview with author.

CAPE CANAVERAL AIR FORCE STATION, LAUNCH COMPLEX 39,
HYPERGOL MAINTENANCE AND CHECKOUT AREA,
HYPERGOL MODULE PROCESSING NORTH
HAER NO. FL-8-11-T-1
PAGE 15

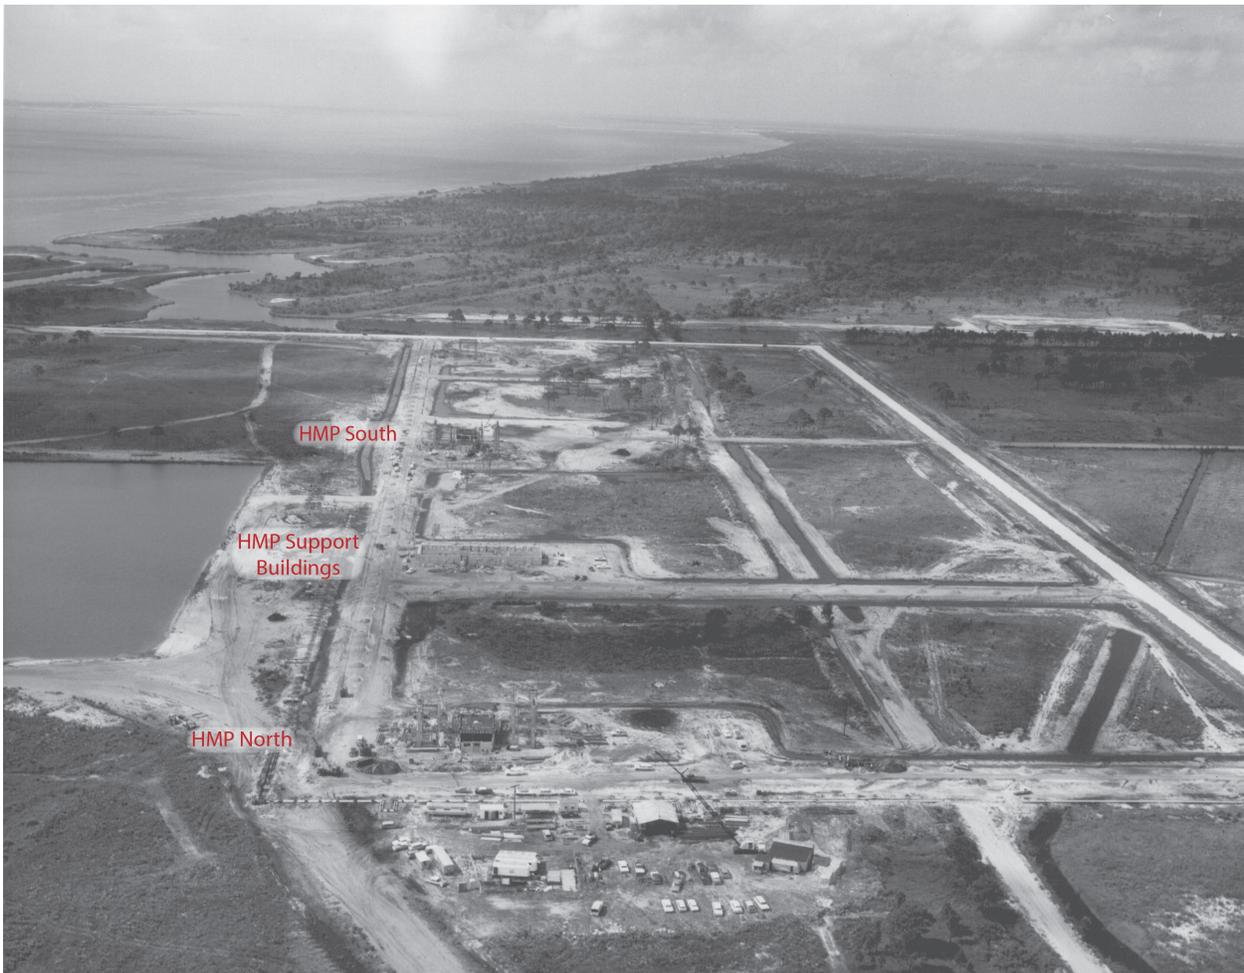

1963 aerial photograph of HMCA Complex under construction with HMP North building site in foreground, view south. (Courtesy KSC: Image LOC-63-7252)

CAPE CANAVERAL AIR FORCE STATION, LAUNCH COMPLEX 39,
HYPERGOL MAINTENANCE AND CHECKOUT AREA,
HYPERGOL MODULE PROCESSING NORTH
HAER NO. FL-8-11-T-1
PAGE 16




1963 view of HMP North under construction, view southwest.
(Courtesy KSC: Image LOC-63-8565).

CAPE CANAVERAL AIR FORCE STATION, LAUNCH COMPLEX 39,
HYPERGOL MAINTENANCE AND CHECKOUT AREA,
HYPERGOL MODULE PROCESSING NORTH
HAER NO. FL-8-11-T-1
PAGE 17



1963 aerial view showing the HMCA area under construction with HMP North in foreground. (Courtesy KSC: Image LOC-63-9100)

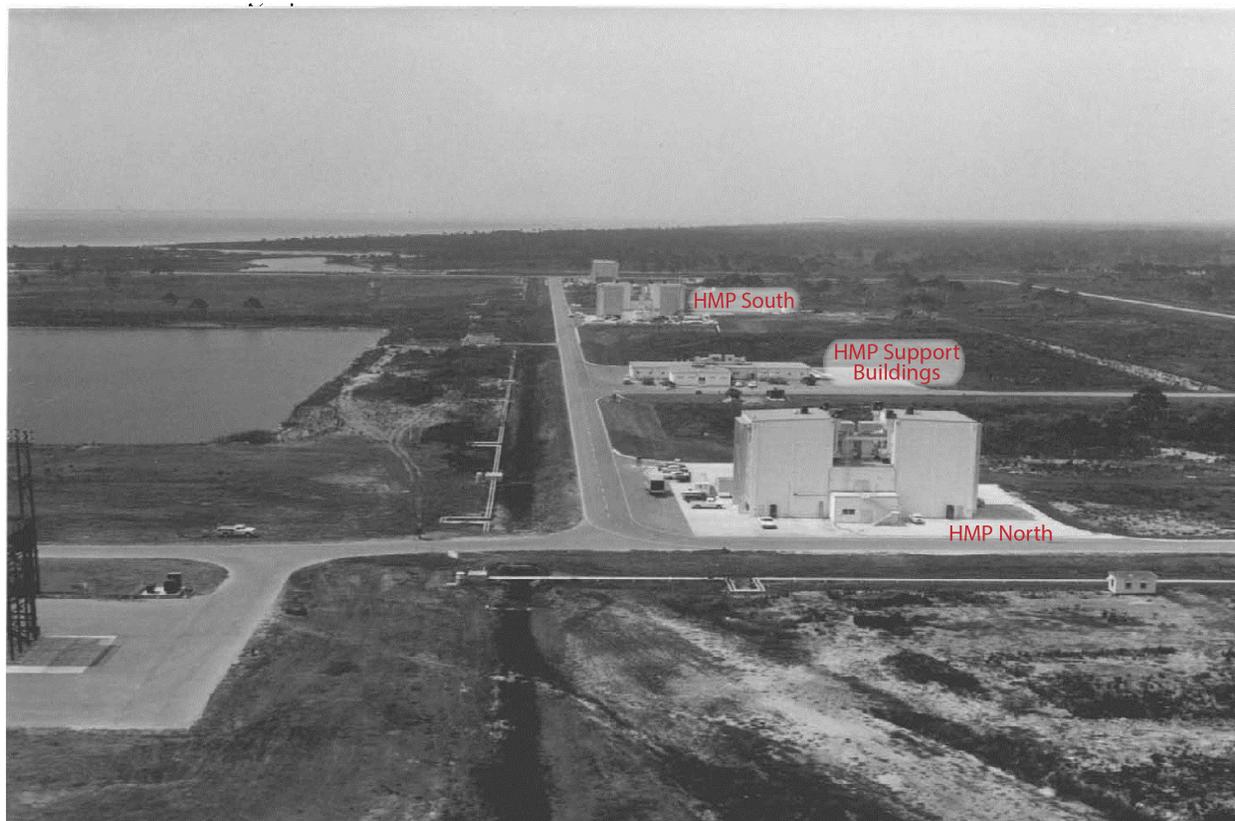


1964 aerial view of the HMCA area shortly after construction,
HMP North in foreground, view south. (Courtesy KSC: Image 100-
KSC-64C-2626)

CAPE CANAVERAL AIR FORCE STATION, LAUNCH COMPLEX 39,
HYPERGOL MAINTENANCE AND CHECKOUT AREA,
HYPERGOL MODULE PROCESSING NORTH
HAER NO. FL-8-11-T-1
PAGE 19




1972 oblique view of HMP North, view southeast. (Courtesy KSC:
Image 107-KSC-72-338).

CAPE CANAVERAL AIR FORCE STATION, LAUNCH COMPLEX 39,
HYPERGOL MAINTENANCE AND CHECKOUT AREA,
HYPERGOL MODULE PROCESSING NORTH
HAER NO. FL-8-11-T-1
PAGE 20

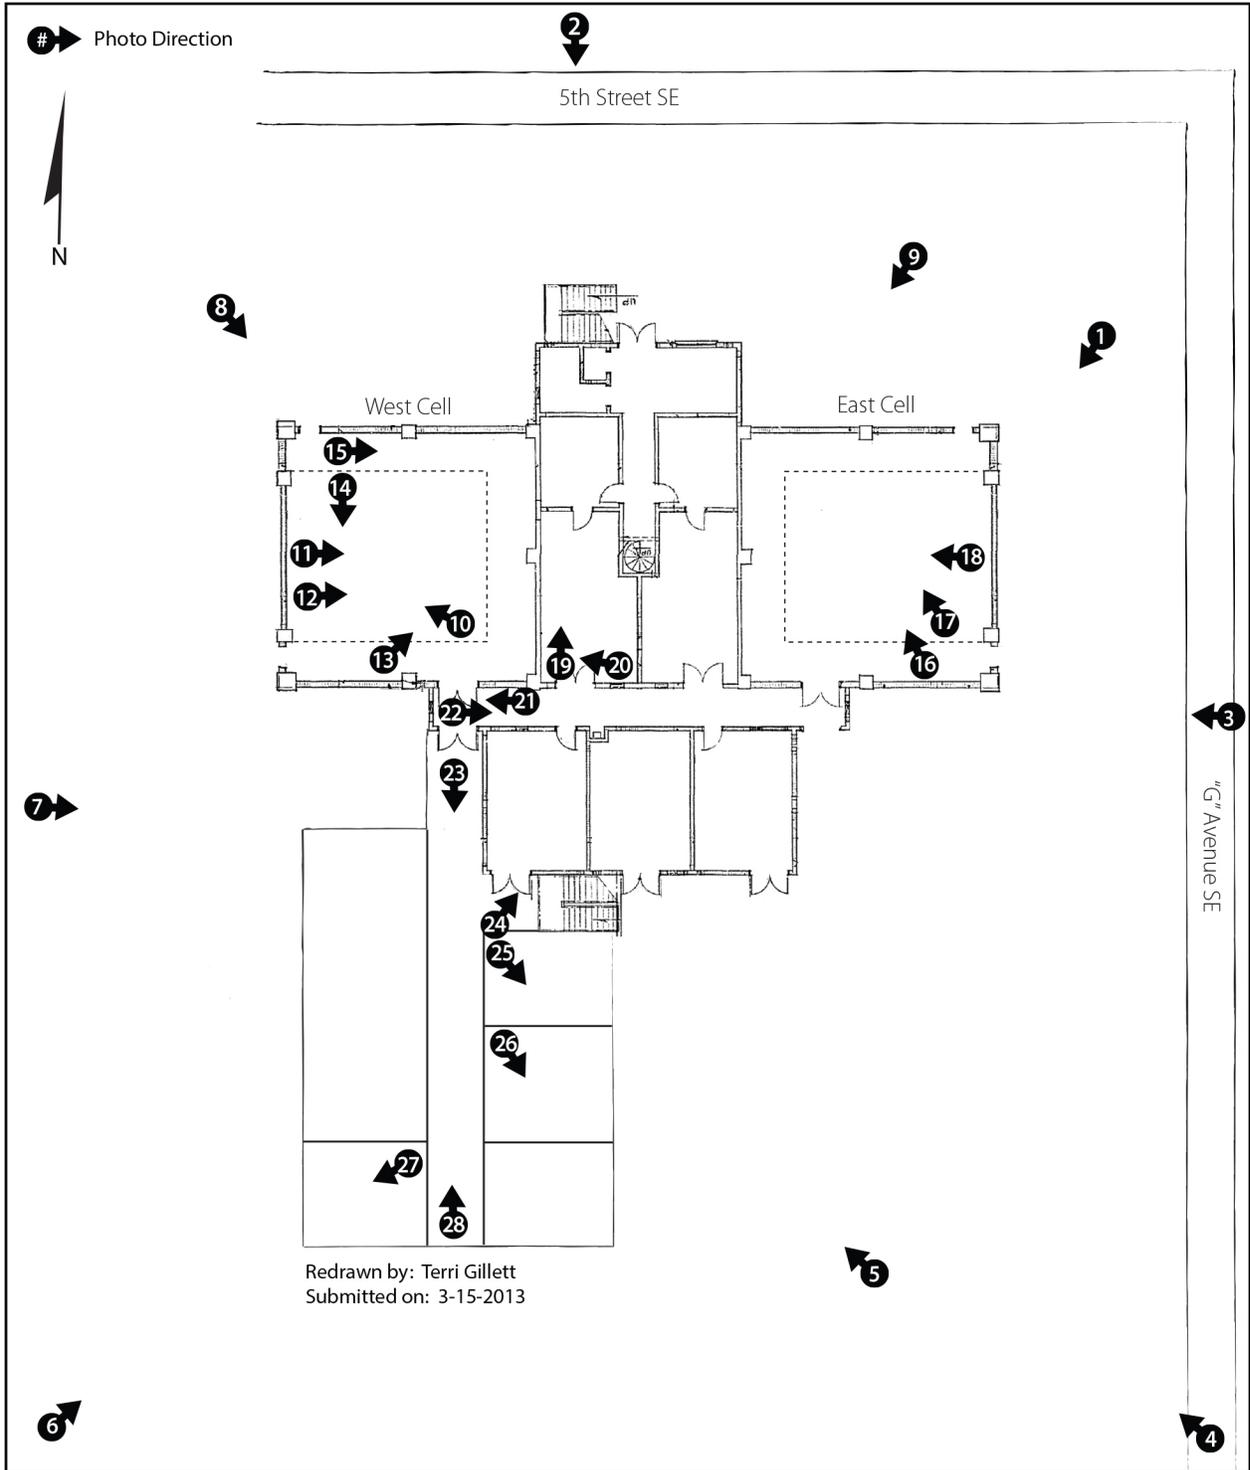

CAPE CANAVERAL AIR FORCE STATION, LAUNCH COMPLEX 39,
HYPERGOL MAINTENANCE AND CHECKOUT AREA,
HYPERGOL MODULE PROCESSING NORTH
HAER NO. FL-8-11-T-1
PAGE 21

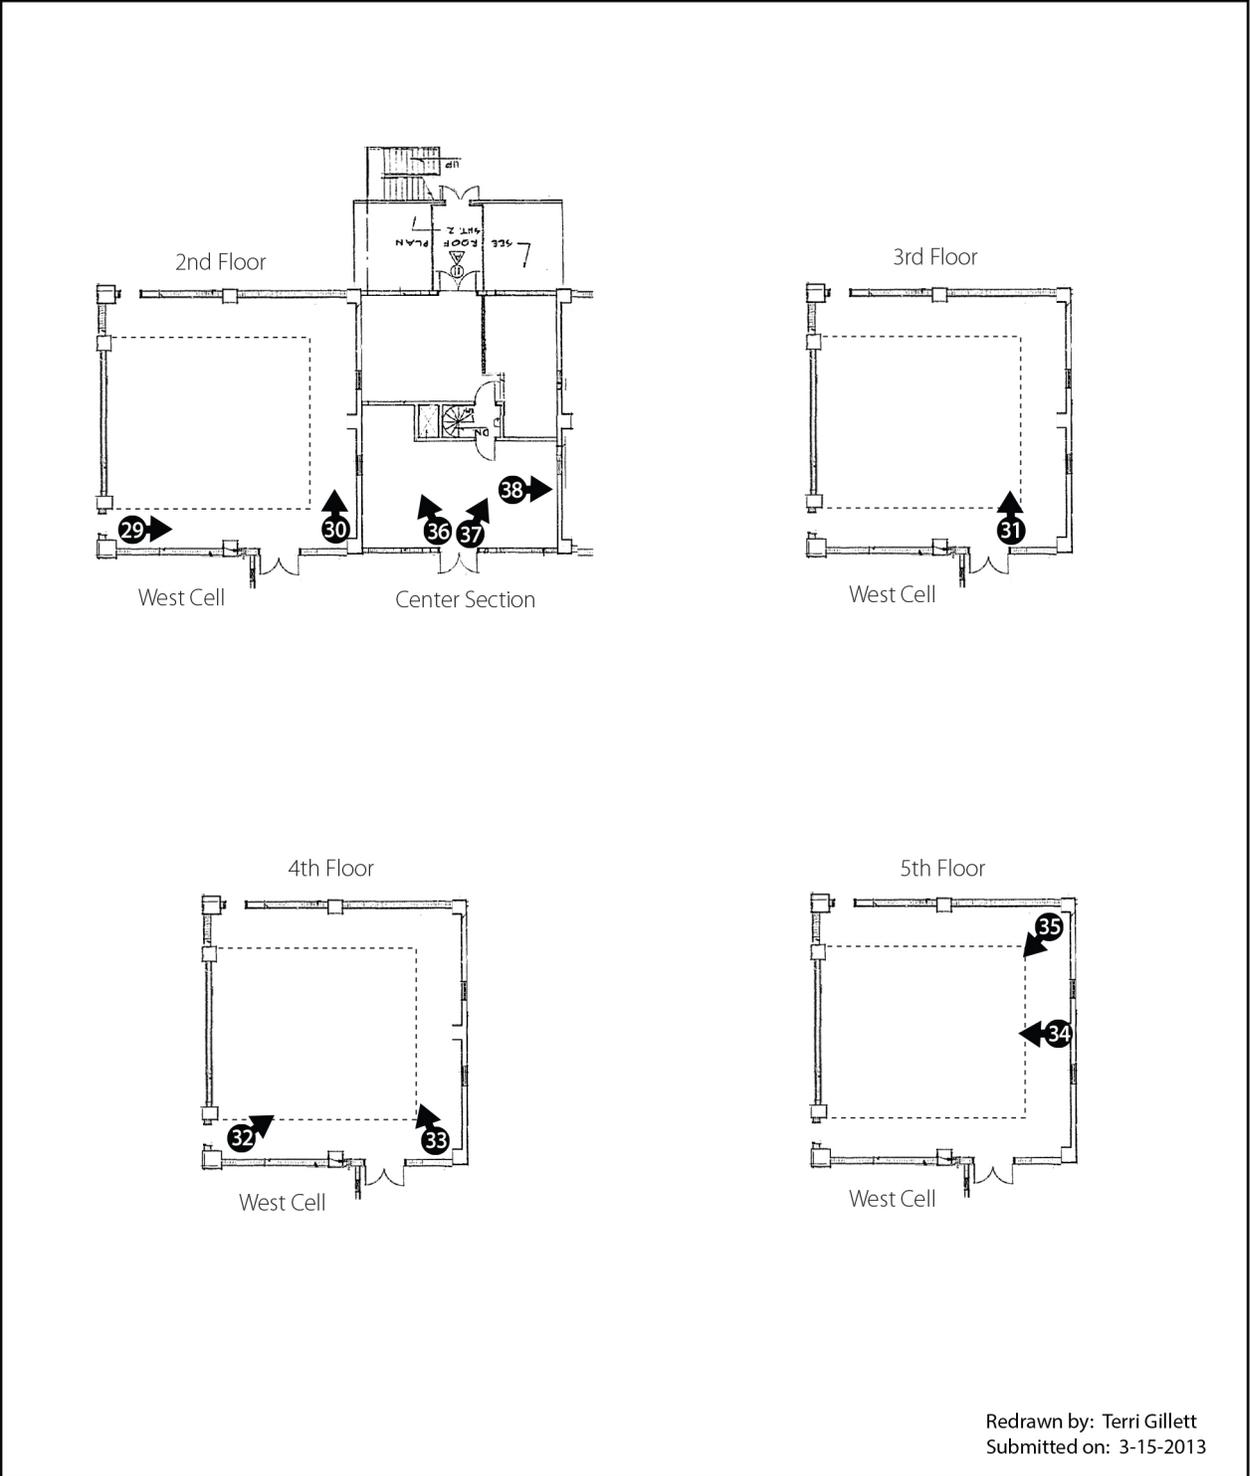

Redrawn by: Terri Gillett
Submitted on: 3-15-2013

HISTORIC AMERICAN ENGINEERING RECORD

INDEX TO PHOTOGRAPHS

HAER No. FL 8-11-T-1

CAPE CANAVERAL AIR FORCE STATION,
LAUNCH COMPLEX 39
HYPERGOL MAINTENANCE AND CHECKOUT AREA,
HYPERGOL MODULE PROCESSING NORTH
(HMP North)
John F. Kennedy Space Center
Cape Canaveral
Brevard County
Florida

David Diener, Photographer

April 2012

FL-8-11-T-1-1	EXTERIOR OBLIQUE VIEW OF HMP NORTH, VIEW SOUTHWEST.
FL-8-11-T-1-2	EXTERIOR NORTH ELEVATION OF HMP NORTH, VIEW SOUTH.
FL-8-11-T-1-3	EXTERIOR EAST ELEVATION OF HMP NORTH, VIEW WEST.
FL-8-11-T-1-4	EXTERIOR OBLIQUE VIEW OF HMP NORTH, VIEW NORTHWEST.
FL-8-11-T-1-5	EXTERIOR DETAIL VIEW OF HMP NORTH PUMPS AND VALVES, VIEW NORTHWEST.
FL-8-11-T-1-6	EXTERIOR OBLIQUE VIEW OF HMP NORTH, VIEW NORTHEAST.
FL-8-11-T-1-7	EXTERIOR WEST ELEVATION OF HMP NORTH, VIEW EAST.
FL-8-11-T-1-8	EXTERIOR DETAIL VIEW OF HMP NORTH PUMPS AND VALVES AT NORTHWEST CORNER OF BUILDING, VIEW SOUTHEAST.
FL-8-11-T-1-9	EXTERIOR DETAIL VIEW OF HMP NORTH PUMPS AND VALVES AND NORTHEAST CORNER OF BUILDING, VIEW SOUTHWEST.
FL-8-11-T-1-10	INTERIOR VIEW OF VERTICAL LIFT DOOR IN HMP NORTH WEST TEST CELL, VIEW NORTHWEST.
FL-8-11-T-1-11	INTERIOR VIEW OF GROUND FLOOR WORK AREA IN HMP NORTH WEST TEST CELL, VIEW EAST.

FL-8-11-T-1-12 INTERIOR VIEW OF UPPER LEVEL WORK AREAS IN HMP NORTH,
WEST TEST CELL, VIEW EAST.

FL-8-11-T-1-13 INTERIOR OBLIQUE VIEW OF GROUND LEVEL WORK AREA IN HMP
NORTH, WEST TEST CELL, VIEW NORTHEAST.

FL-8-11-T-1-14 INTERIOR VIEW OF GROUND LEVEL WORK AREA IN HMP NORTH,
WEST TEST CELL, VIEW SOUTHEAST.

FL-8-11-T-1-15 INTERIOR VIEW OF GROUND LEVEL WORK AREA IN HMP NORTH,
WEST TEST CELL WITH PROPELLANT LINES AND TUBING, VIEW
EAST.

FL-8-11-T-1-16 INTERIOR VIEW OF GROUND FLOOR WORK AREA IN HMP NORTH,
EAST TEST CELL, VIEW NORTHWEST.

FL-8-11-T-1-17 INTERIOR VIEW OF GROUND FLOORWORK AREA IN HMP NORTH,
EAST TEST CELL, VIEW NORTHWEST.

FL-8-11-T-1-18 INTERIOR VIEW OF UPPER LEVEL WORK AREAS AND CEILING IN
HMP NORTH, EAST TEST CELL, VIEW NORTHWEST.

FL-8-11-T-1-19 LOCKER AND EQUIPMENT ROOM ON GROUND FLOOR OF HMP
NORTH, VIEW NORTH.

FL-8-11-T-1-20 WORK BENCH AND CALIBRATING EQUIPMENT IN HMP NORTH,
VIEW WEST.

FL-8-11-T-1-21 INTERIOR VIEW OF ENTRANCE DOOR TO HMP NORTH, WEST TEST
CELL, VIEW WEST.

FL-8-11-T-1-22 CORRIDOR IN HMP NORTH CONNECTING WEST AND EAST TEST
CELLS, VIEW EAST.

FL-8-11-T-1-23 CORRIDOR IN HMP NORTH LEADING TO LABORATORY AREAS IN
SOUTH WING OF BUILDING, VIEW SOUTH.

FL-8-11-T-1-24 THRUST BENCH TEST LAB IN HMP NORTH, VIEW NORTHEAST.

FL-8-11-T-1-25 QUICK DISCONNECT LABORATORY IN HMP NORTH, VIEW
SOUTHEAST.

FL-8-11-T-1-26 GENERAL SHOP AREA IN HMP NORTH, VIEW SOUTHEAST.

FL-8-11-T-1-27 THERMAL CONTROL SYSTEM LABORATORY IN HMP NORTH, VIEW
SOUTHWEST.

FL-8-11-T-1-28 CORRIDOR IN HMP NORTH SOUTH WING, VIEW NORTH.

FL-8-11-T-1-29 INTERIOR VIEW OF SECOND FLOOR WORK AREA IN HMP NORTH
WEST TEST CELL ALONG SOUTH WALL, VIEW EAST.

FL-8-11-T-1-30 INTERIOR VIEW OF SECOND FLOOR WORK AREA IN HMP NORTH,
WEST TEST CELL ALONG EAST WALL, VIEW NORTH.

FL-8-11-T-1-31 INTERIOR VIEW OF THIRD FLOOR WORK AREA IN HMP NORTH,
WEST TEST CELL ALONG EAST WALL, VIEW NORTH.

FL-8-11-T-1-32 INTERIOR OBLIQUE VIEW OF HMP NORTH, WEST TEST CELL
FROM FOURTH FLOOR, VIEW NORTHEAST.

FL-8-11-T-1-33 INTERIOR OBLIQUE VIEW OF HMP NORTH, WEST TEST CELL
FROM FOURTH FLOOR, VIEW NORTHWEST.

FL-8-11-T-1-34 INTERIOR OBLIQUE VIEW OF HMP NORTH, WEST TEST CELL
FROM FIFTH FLOOR, VIEW SOUTHWEST.

FL-8-11-T-1-35 INTERIOR VIEW OF VERTICAL LIFT DOOR IN HMP NORTH, WEST
TEST CELL FROM FIFTH FLOOR, VIEW WEST.

FL-8-11-T-1-36 HIM ROOM EQUIPMENT IN HMP NORTH, VIEW NORTHWEST.

FL-8-11-T-1-37 HIM ROOM EQUIPMENT IN HMP NORTH, VIEW NORTHEAST.

FL-8-11-T-1-38 OBSERVATION FROM HIM ROOM TO EAST TEST CELL IN HMP
NORTH, VIEW EAST.

FL-8-11-T-1-39 PHOTOCOPY OF ENGINEERING DRAWINGS (8" X 10" PHOTO OF
SCANNED ORIGINAL; MARCH 5, 1963 BY TAMPA BAY
ENGINEERING CO.; DRAWING IN POSSESSION OF KENNEDY
SPACE CENTER) FLUID TEST COMPLEX, ENVIRONMENTAL
CONTROL SYSTEMS BLDG, ARCHITECTURAL FLOOR PLANS &
DETAILS"

FL-8-11-T-1-40 PHOTOCOPY OF ENGINEERING DRAWINGS (8" X 10" PHOTO OF
SCANNED ORIGINAL; MARCH 5, 1963 BY TAMPA BAY
ENGINEERING CO.; DRAWING IN POSSESSION OF KENNEDY
SPACE CENTER) "LIFE SUPPORT TEST, ARCHITECTURAL
ELEVATIONS"

FL-8-11-T-1-41 PHOTOCOPY OF ENGINEERING DRAWINGS (8" X 10" PHOTO OF
SCANNED ORIGINAL; MARCH 5, 1963 BY TAMPA BAY
ENGINEERING CO.; DRAWING IN POSSESSION OF KENNEDY
SPACE CENTER) "LIFE SUPPORT TEST, SECTIONS & DETAILS"

FL-8-11-T-1-42 PHOTOCOPY OF ENGINEERING DRAWINGS (8" X 10" PHOTO OF
SCANNED ORIGINAL; MARCH 5, 1963 BY TAMPA BAY
ENGINEERING CO.; DRAWING IN POSSESSION OF KENNEDY
SPACE CENTER) "LIFE SUPPORT TEST, SECTIONS & DETAILS"

FL-8-11-T-1-43 PHOTOCOPY OF ENGINEERING DRAWINGS (8" X 10" PHOTO OF
SCANNED ORIGINAL; MARCH 5, 1963 BY TAMPA BAY
ENGINEERING CO.; DRAWING IN POSSESSION OF KENNEDY
SPACE CENTER) "FLUID TEST COMPLEX, E.C.S. BUILDING,
AIR CONDITIONING DUCT L.O. & DET. (FIRST FLOOR)"

FL-8-11-T-1-44 PHOTOCOPY OF ENGINEERING DRAWINGS (8" X 10" PHOTO OF
SCANNED ORIGINAL; MARCH 5, 1963 BY TAMPA BAY
ENGINEERING CO.; DRAWING IN POSSESSION OF KENNEDY
SPACE CENTER) "FLUID TEST COMPLEX, ENVIRONMENTAL CONT.
SYST. BLDG., HEATING, VENTILATION & AIR COND., SECOND
FLOOR & ROOF PLAN"

FL-8-11-T-1-45 PHOTOCOPY OF ENGINEERING DRAWINGS (8" X 10" PHOTO OF
SCANNED ORIGINAL; MARCH 5, 1963 BY TAMPA BAY
ENGINEERING CO.; DRAWING IN POSSESSION OF KENNEDY
SPACE CENTER) "LIFE SUPPORT TEST, HEATING, VENTILATION
& AIR CONDITIONING - SECTIONS"



KODAK 100T MX



Kodak 100 TMX



KODAK 100T MX





KODAK 100T MX




Kodak 100T MX










Kodak 100T MX

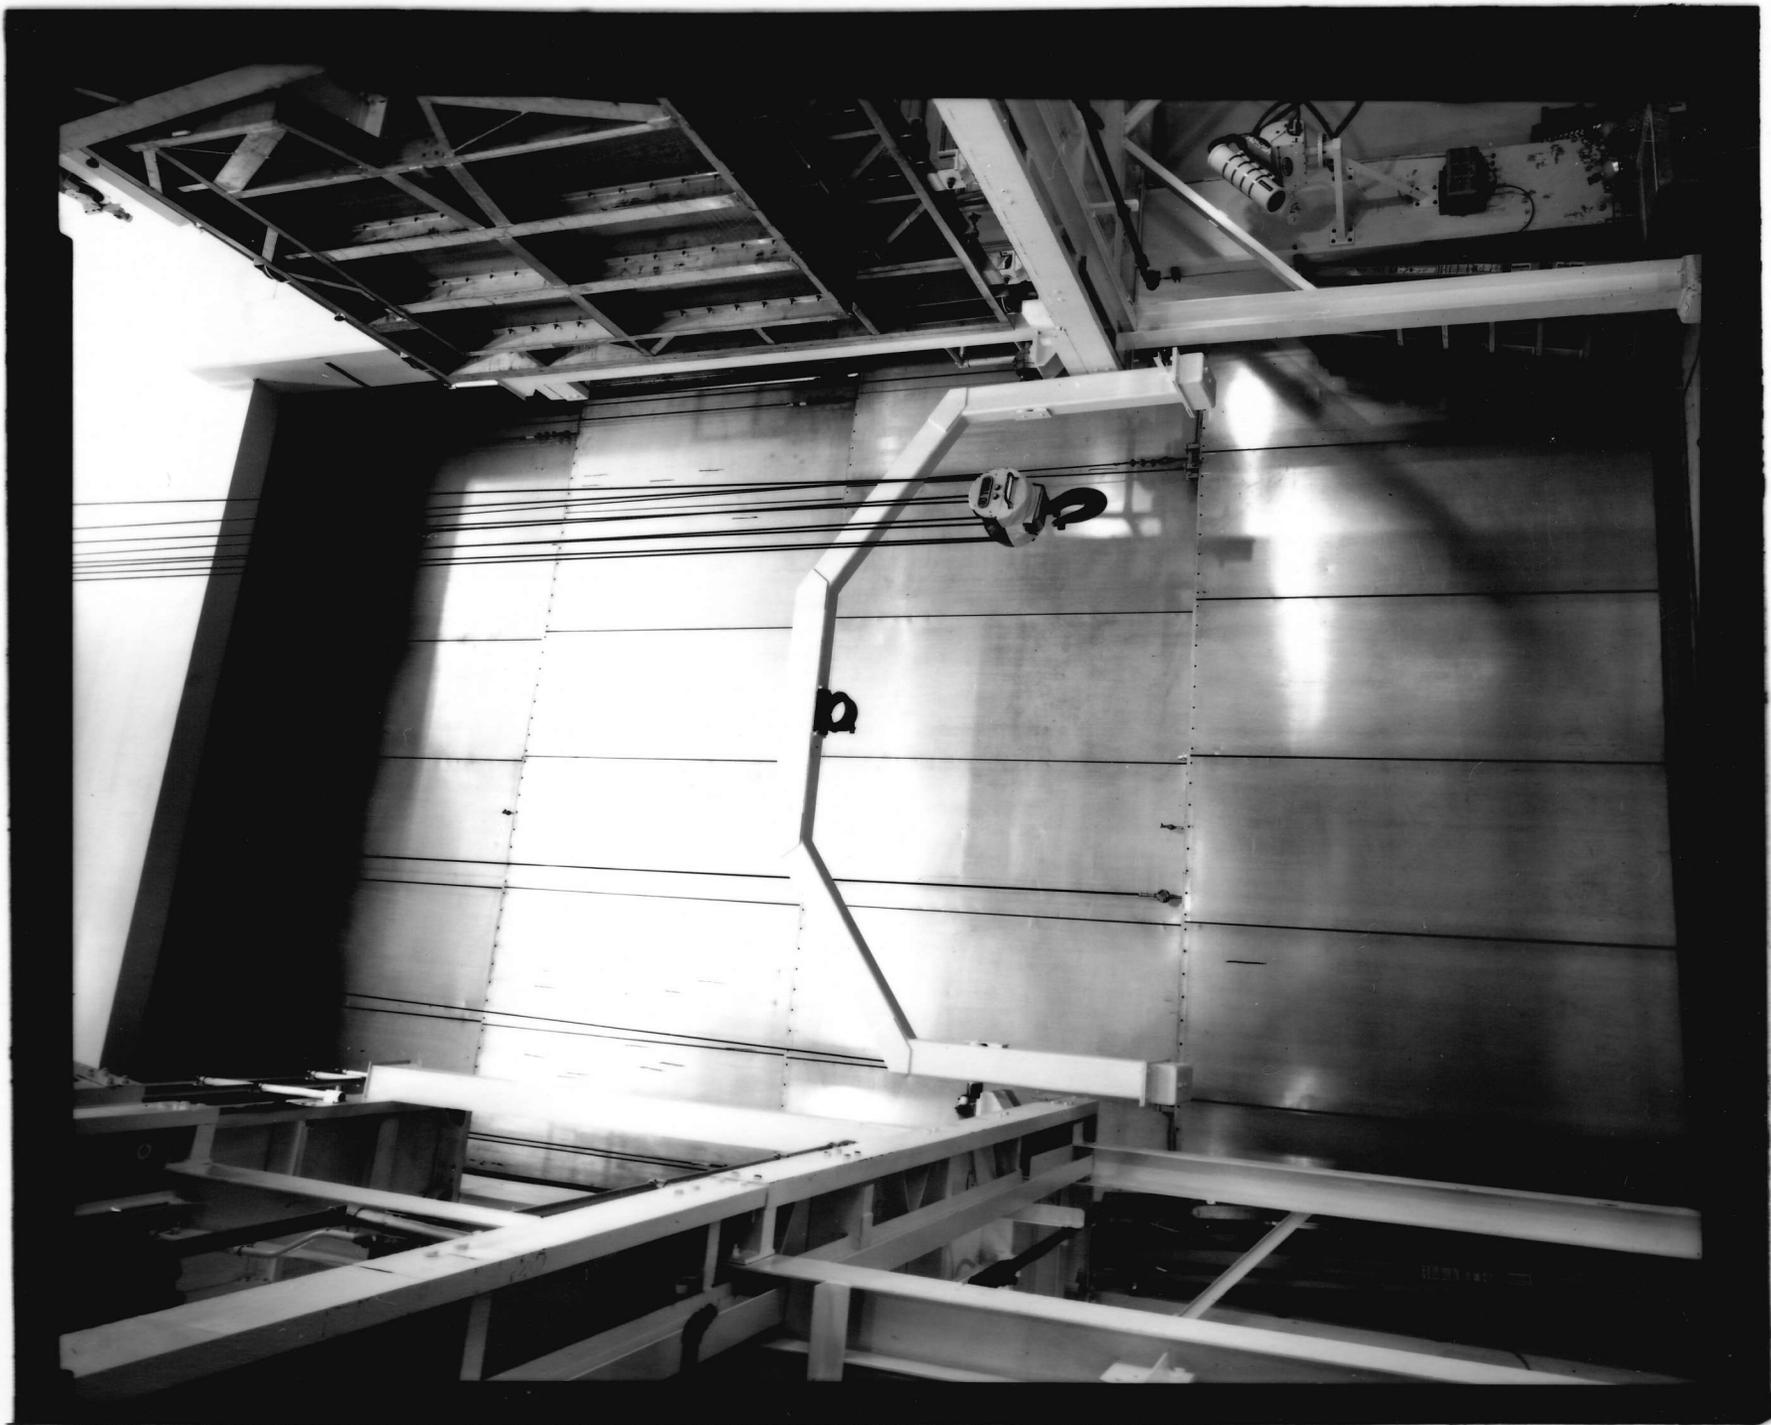

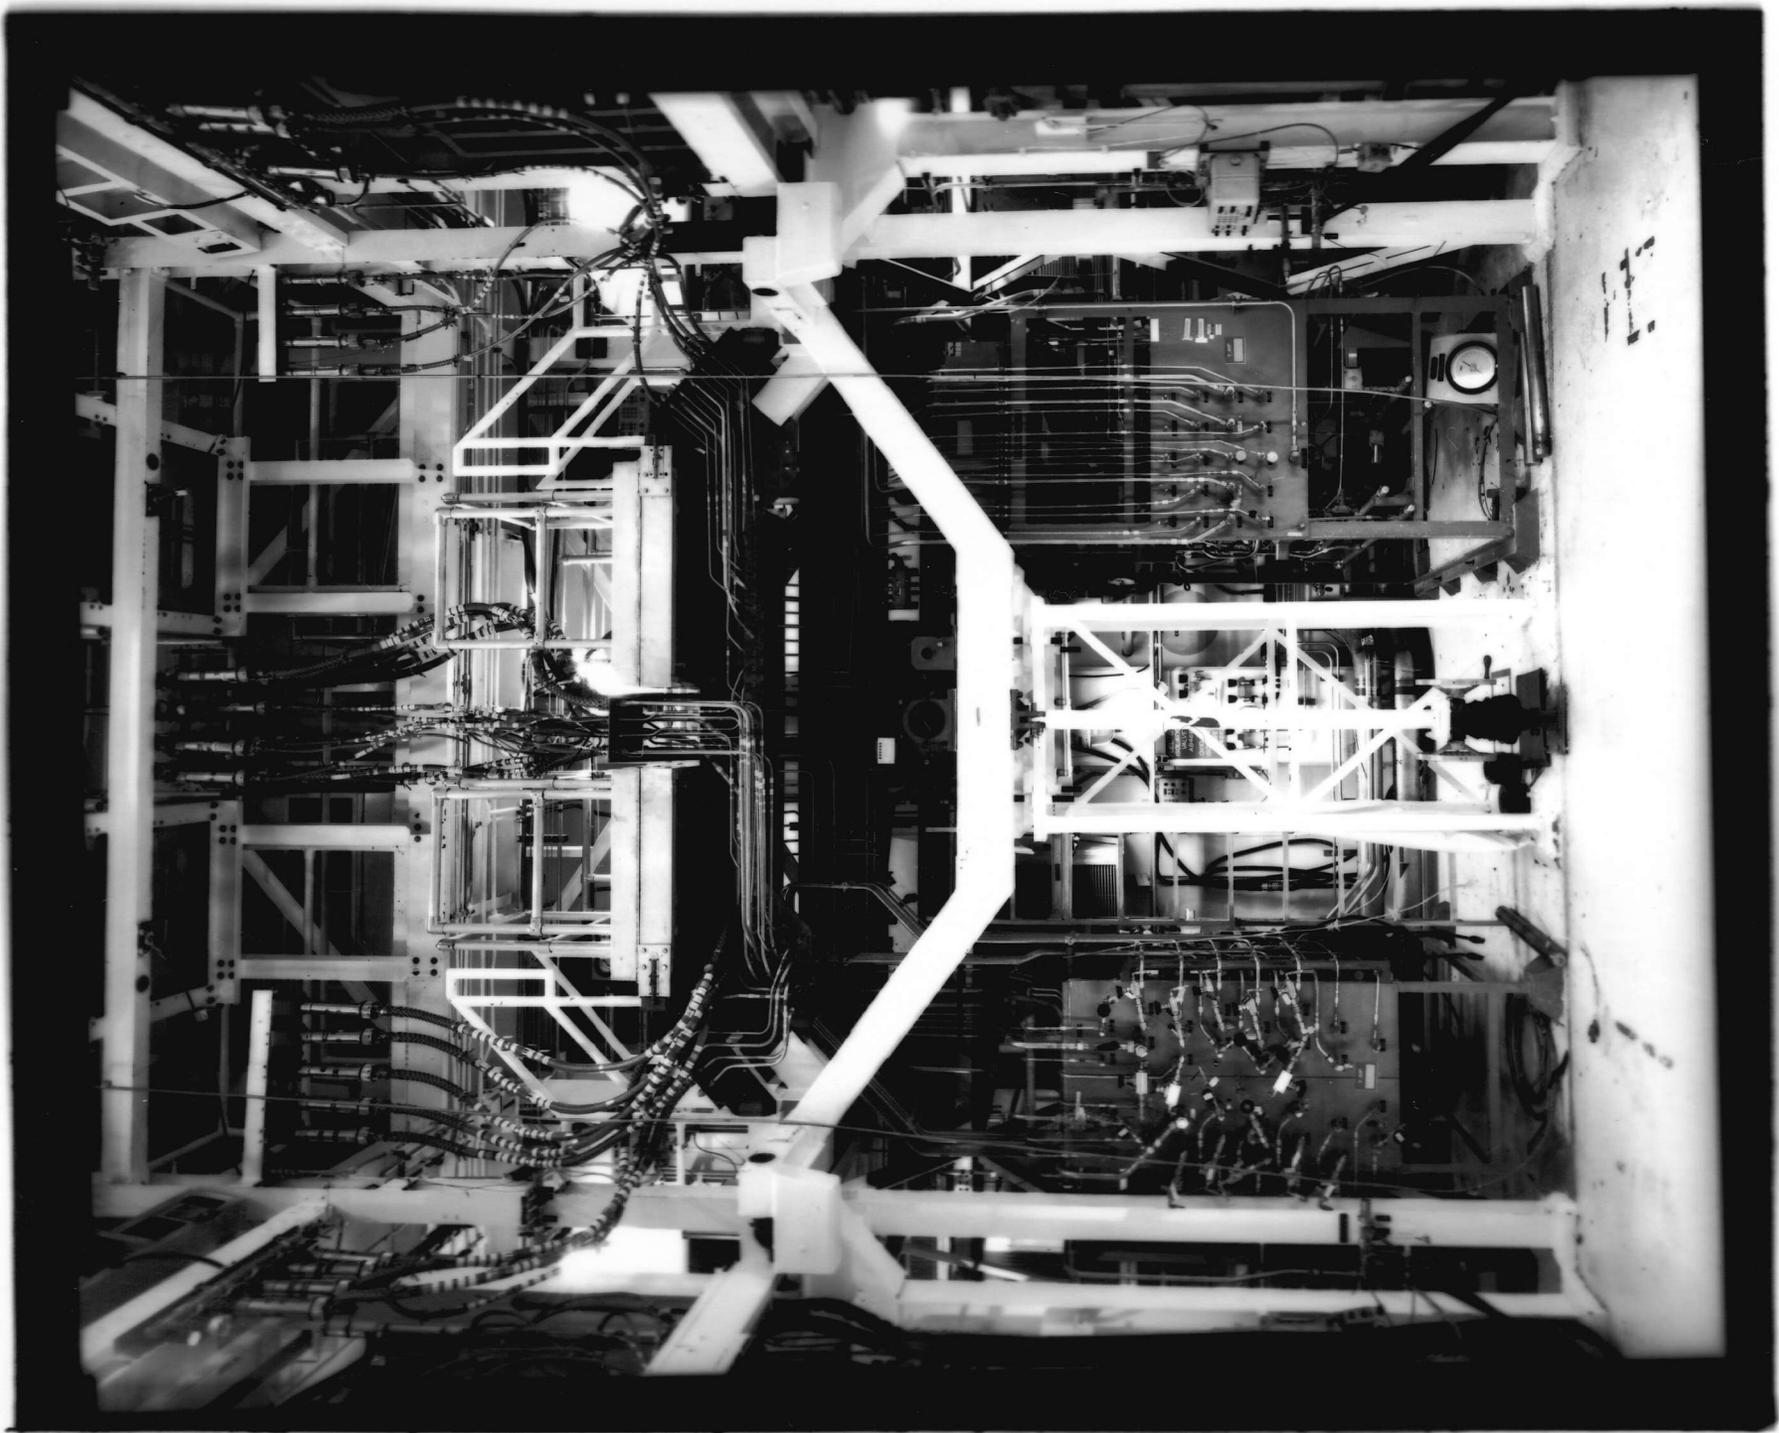

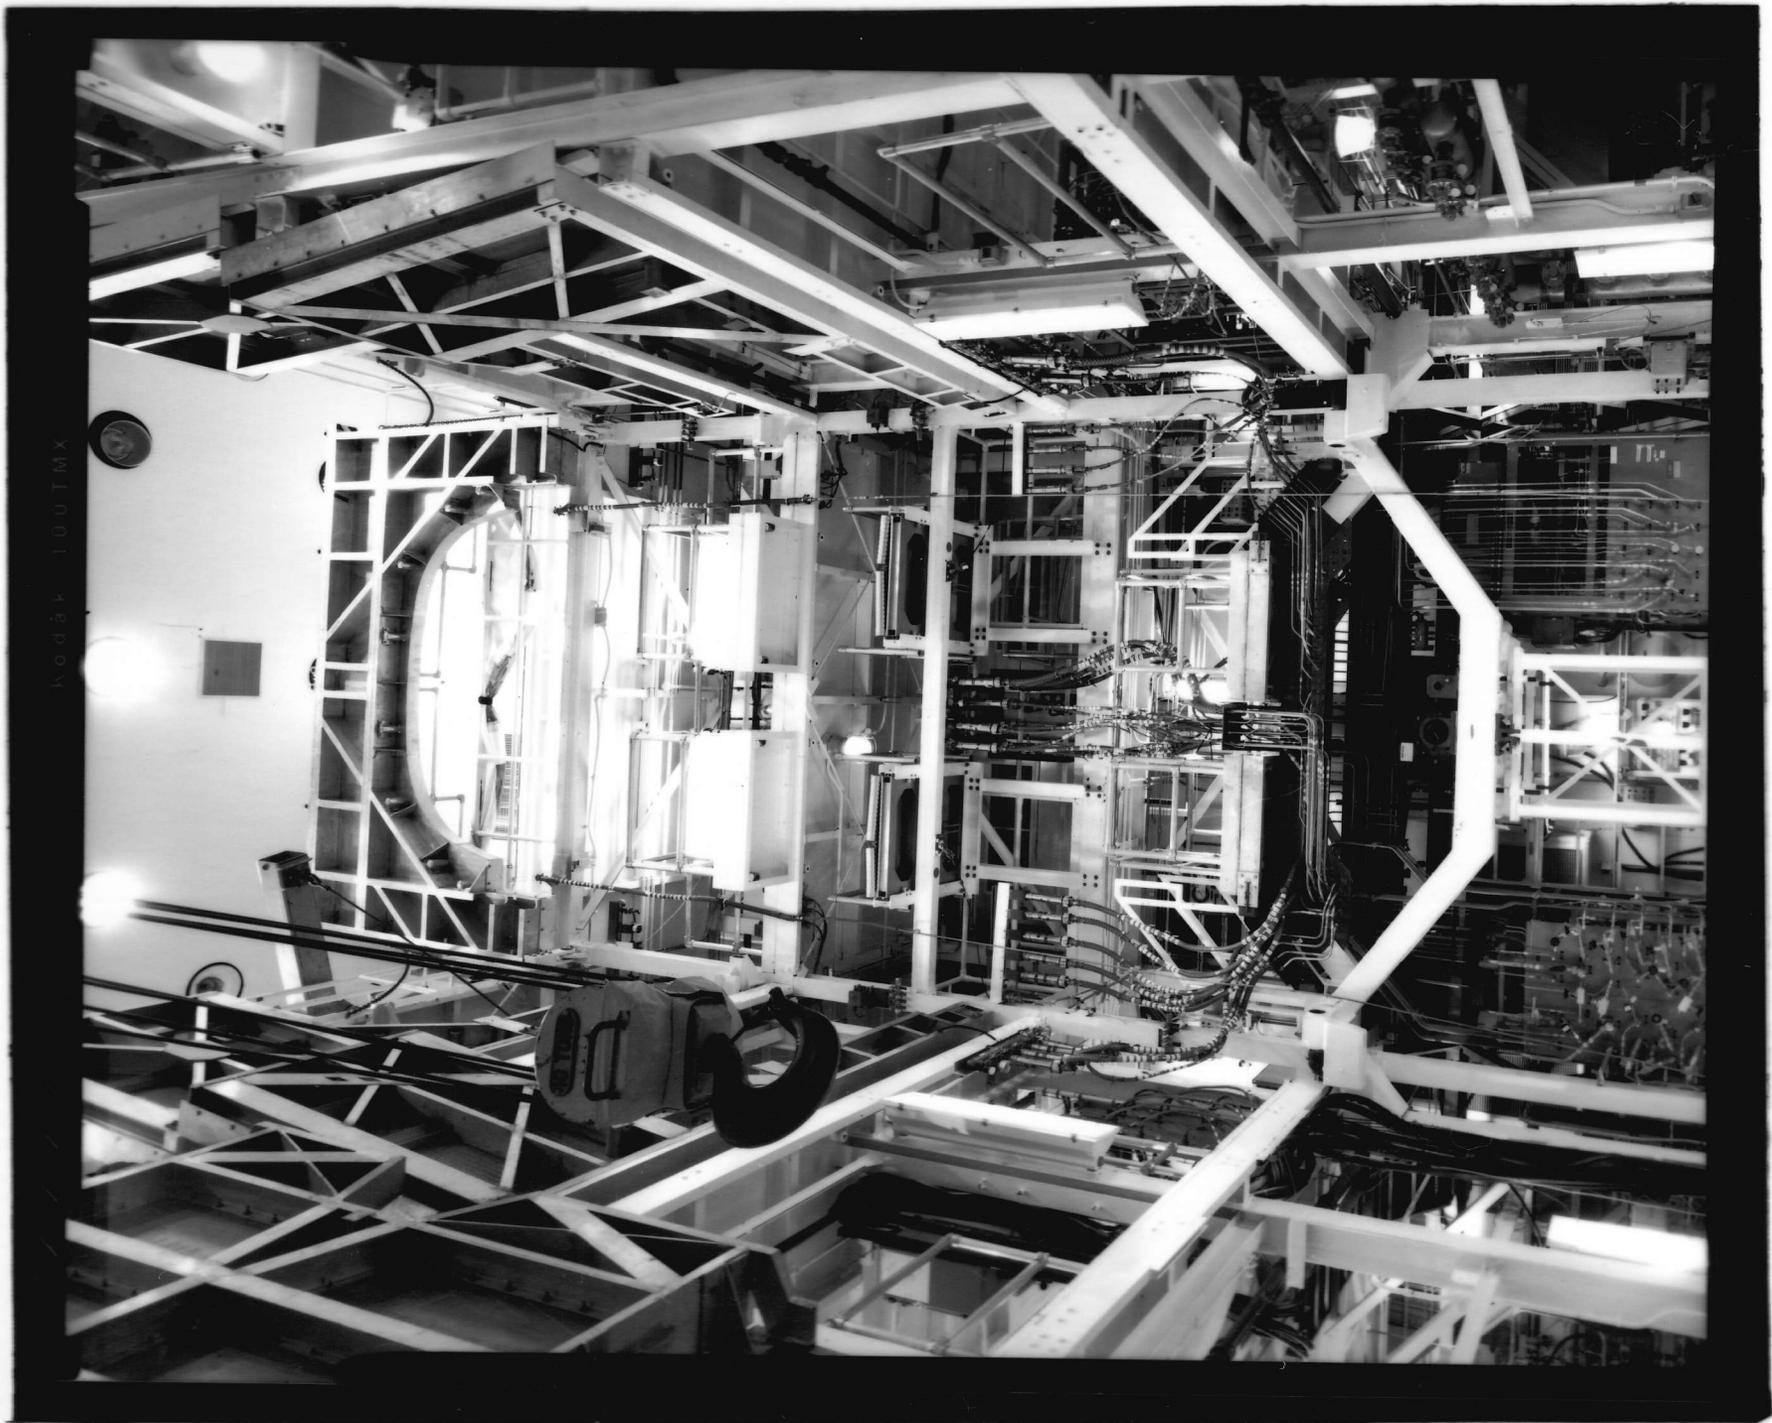

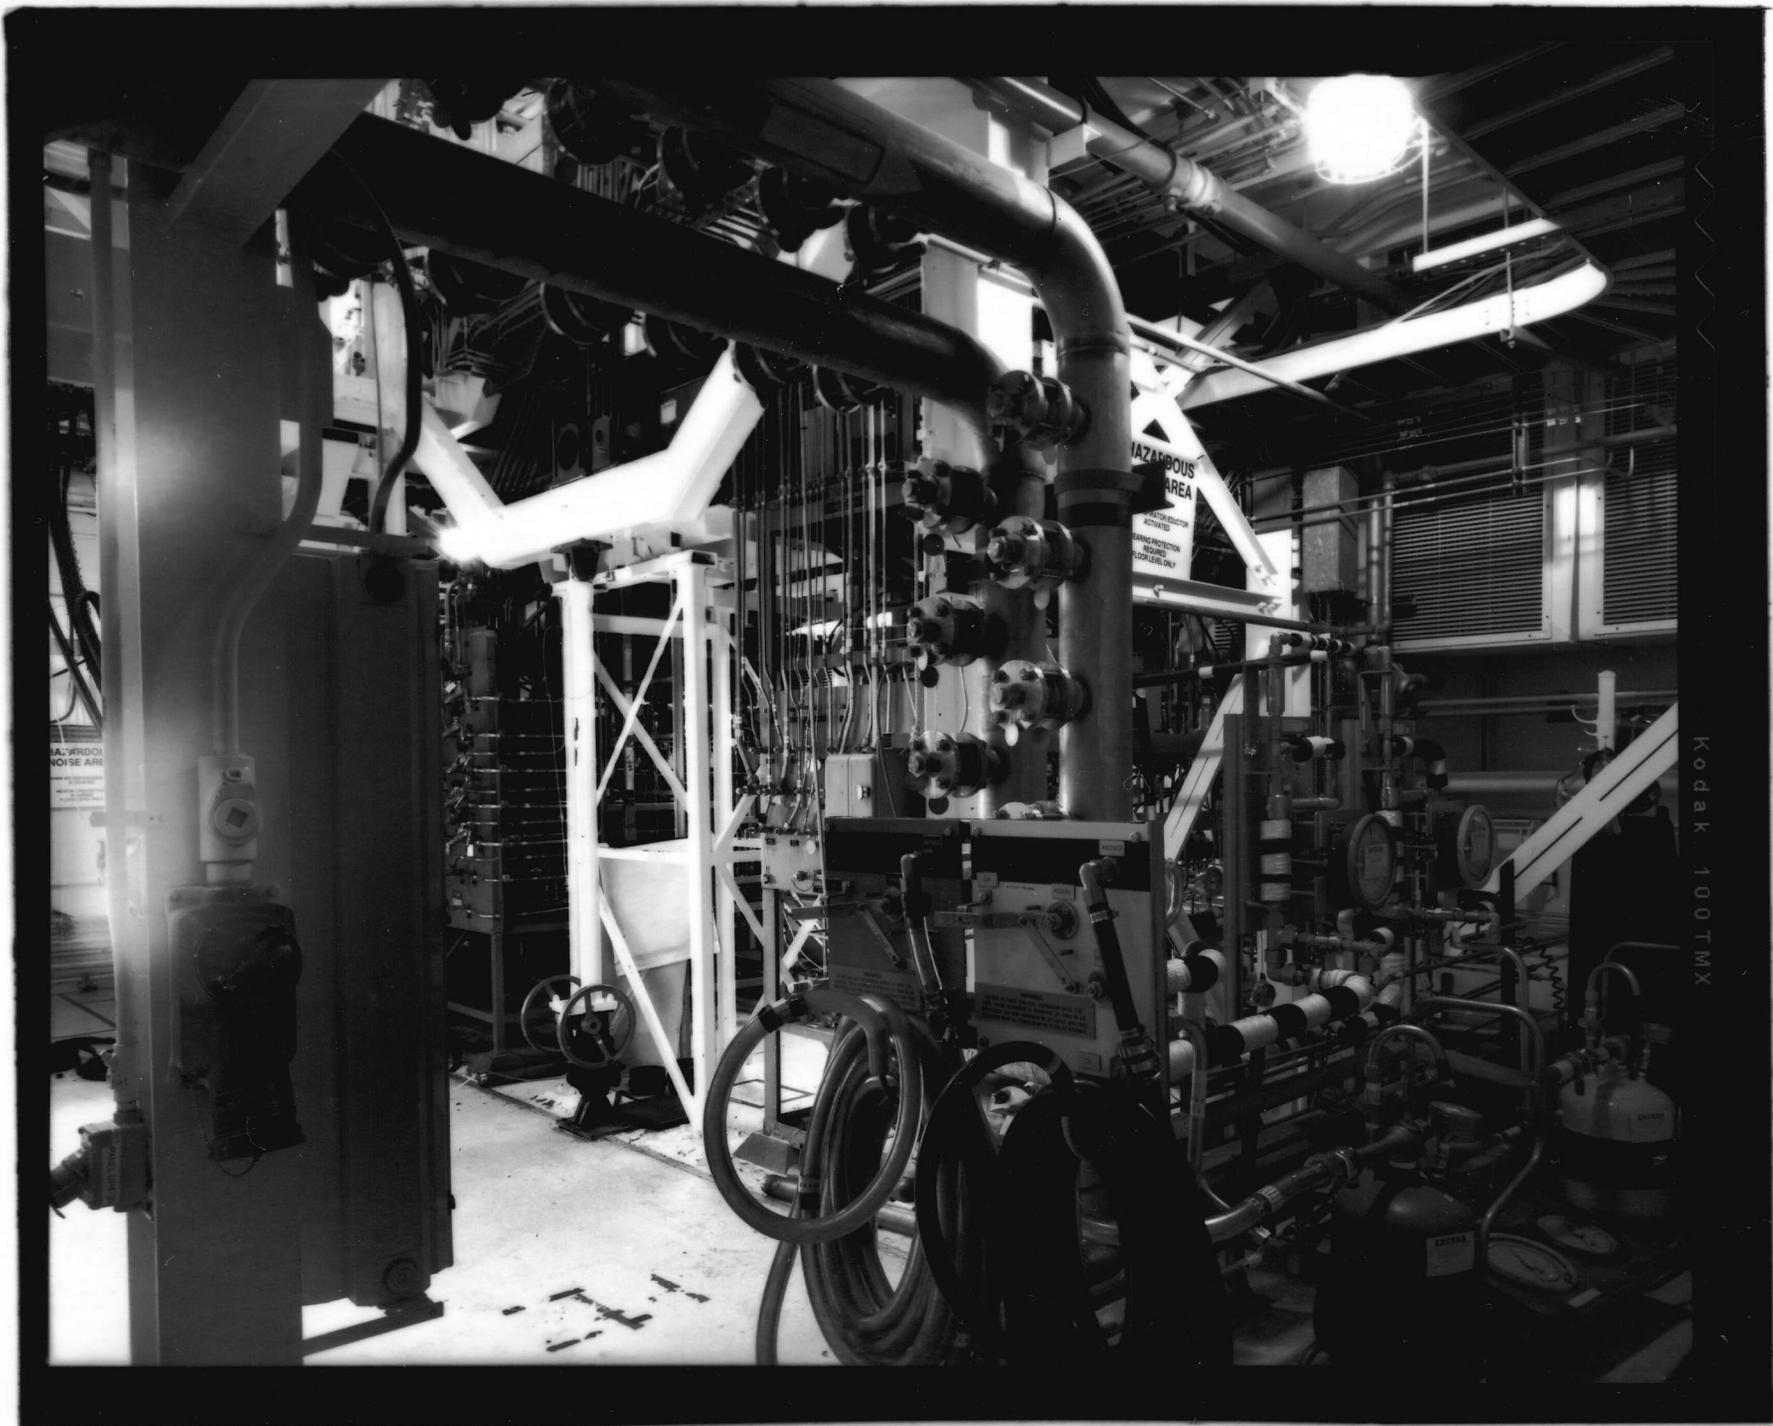


HAZARDOUS
AREA

ALL PERSONS ENTERING
THIS AREA MUST WEAR
RADIATION PROTECTION
EQUIPMENT AT ALL TIMES


HAZARDOUS
NOISE AREA

Kodak 100T MX




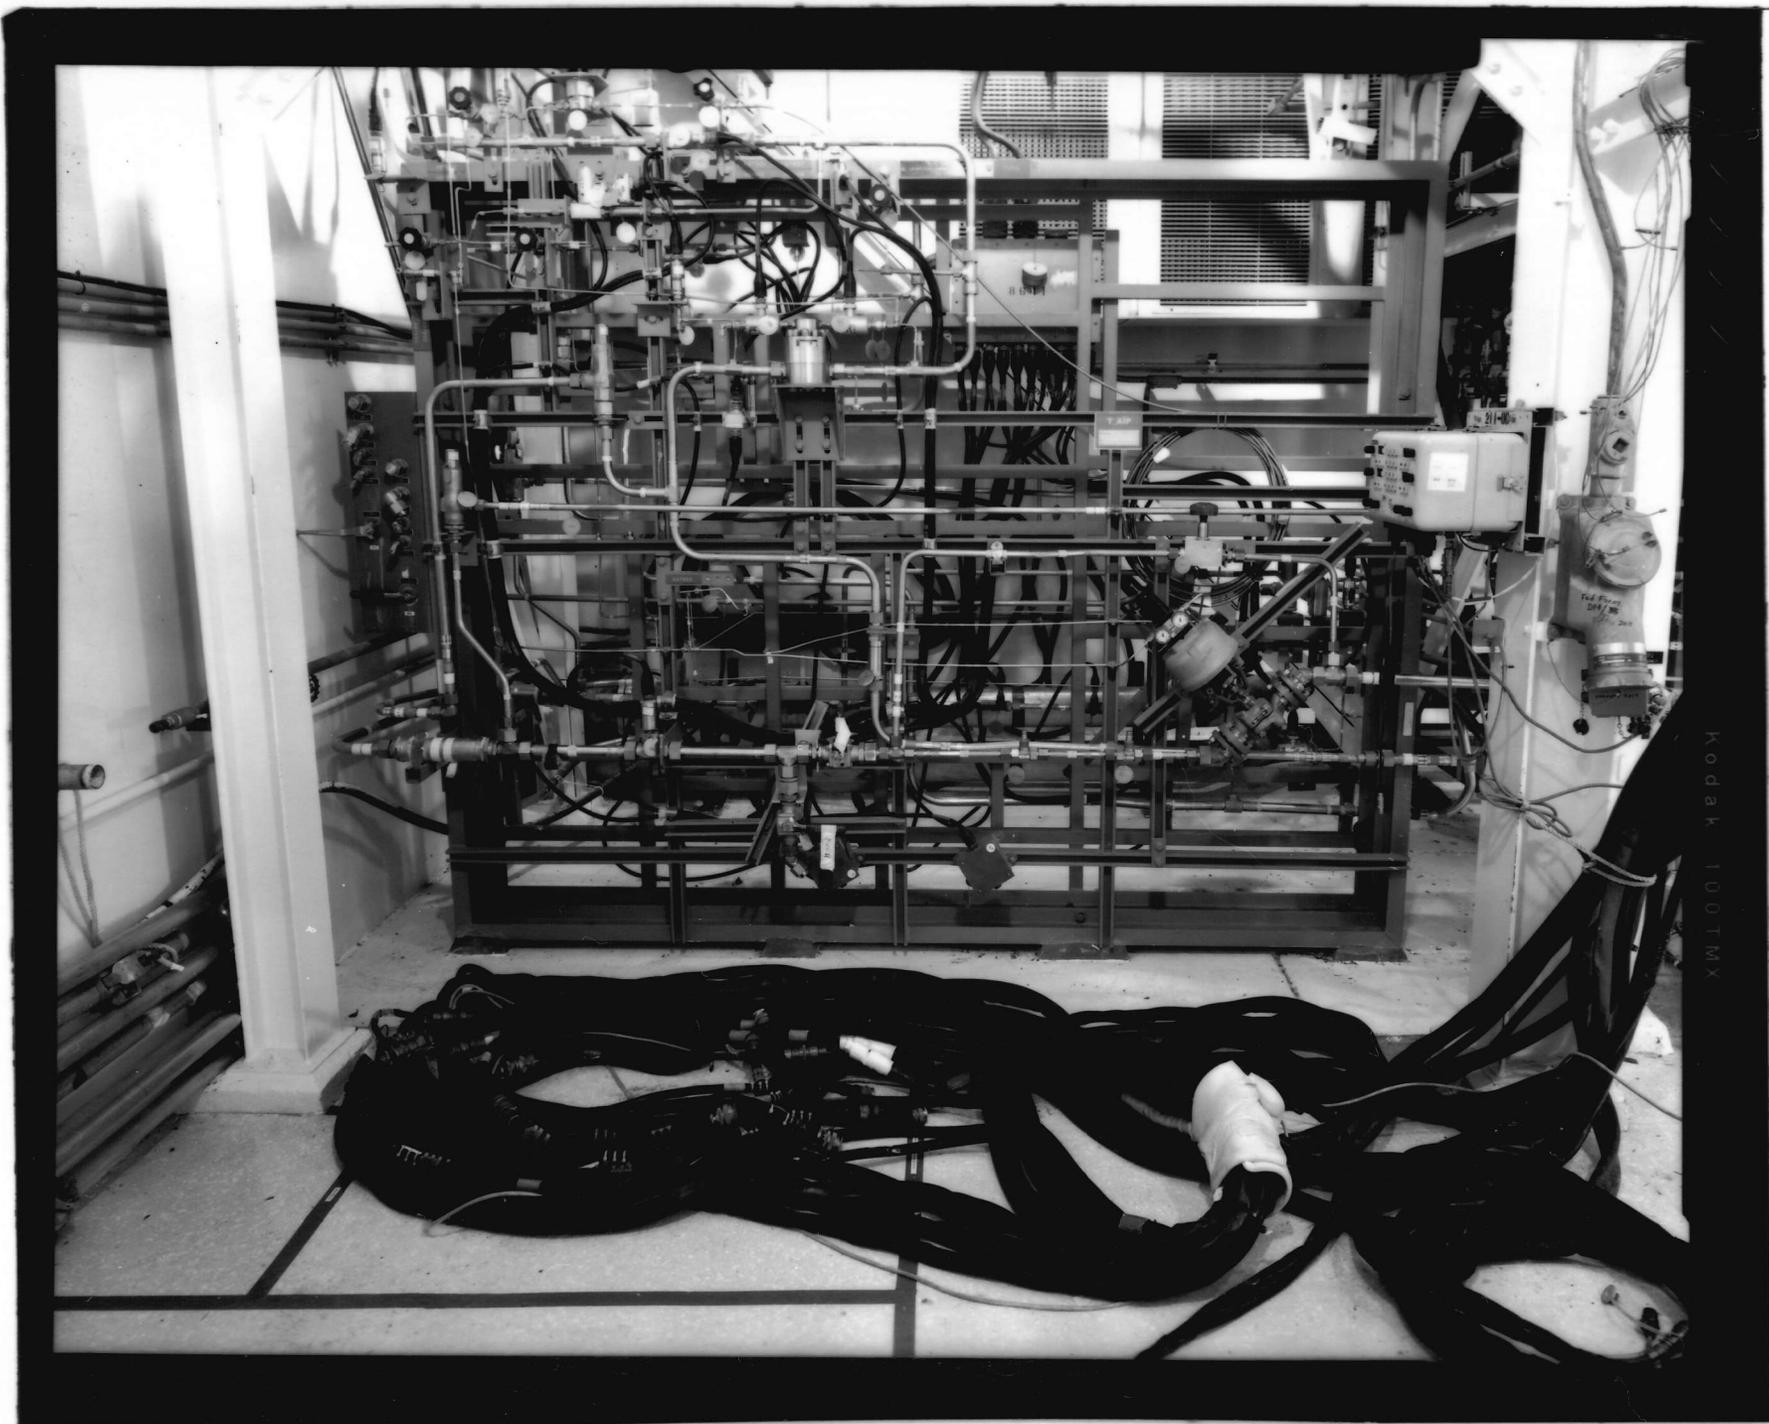

Kodak 100T MX

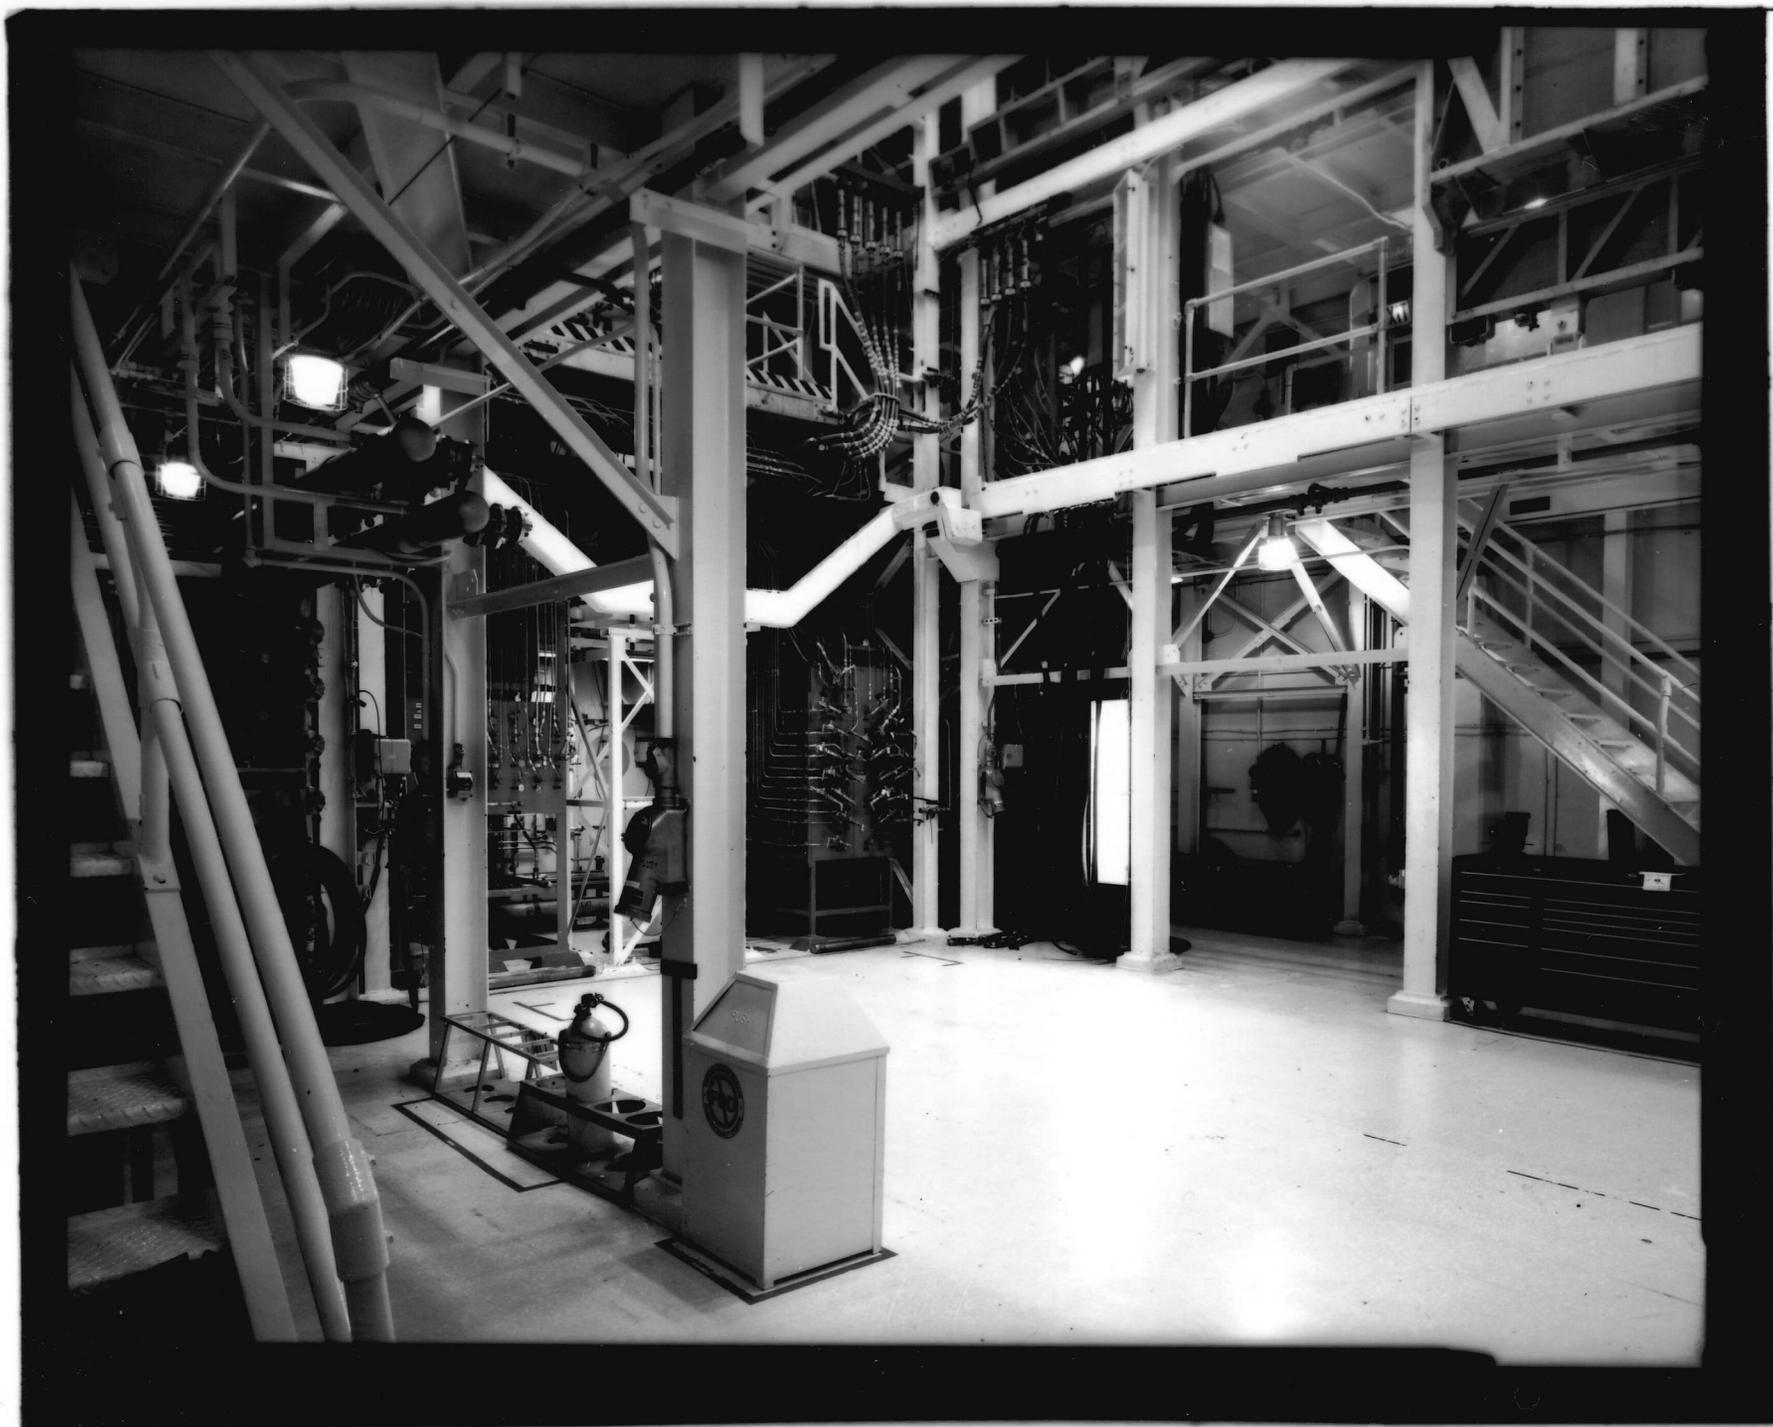



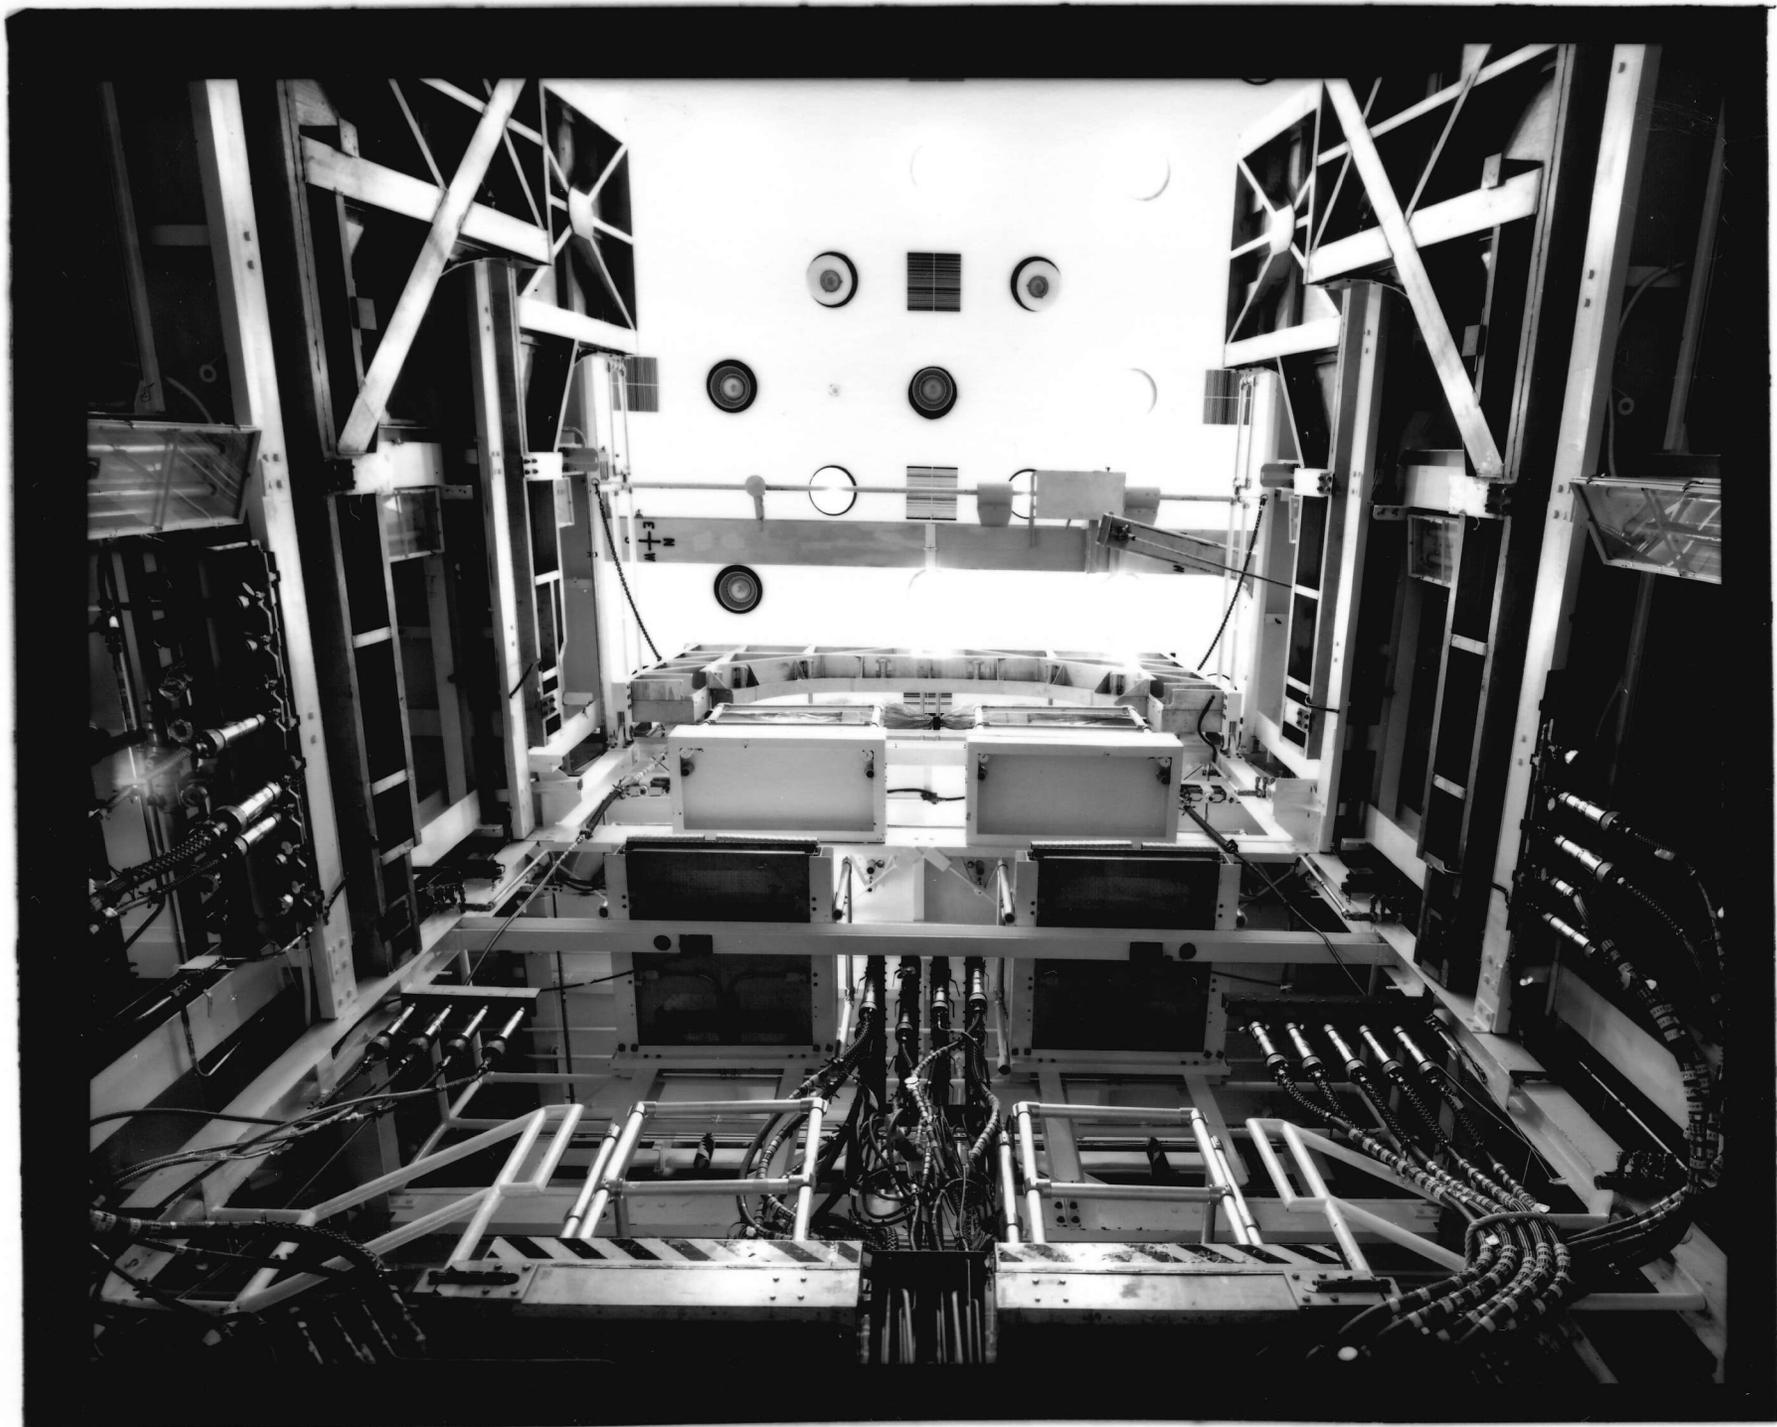





Kodak 100T MX



KODAK 100T MX



KODAK 100T MX




Kodak 100T MX



3 SPARE PARTS

FLAMMABLE
KEEP AWAY FROM HEAT

KODAK 100T MX

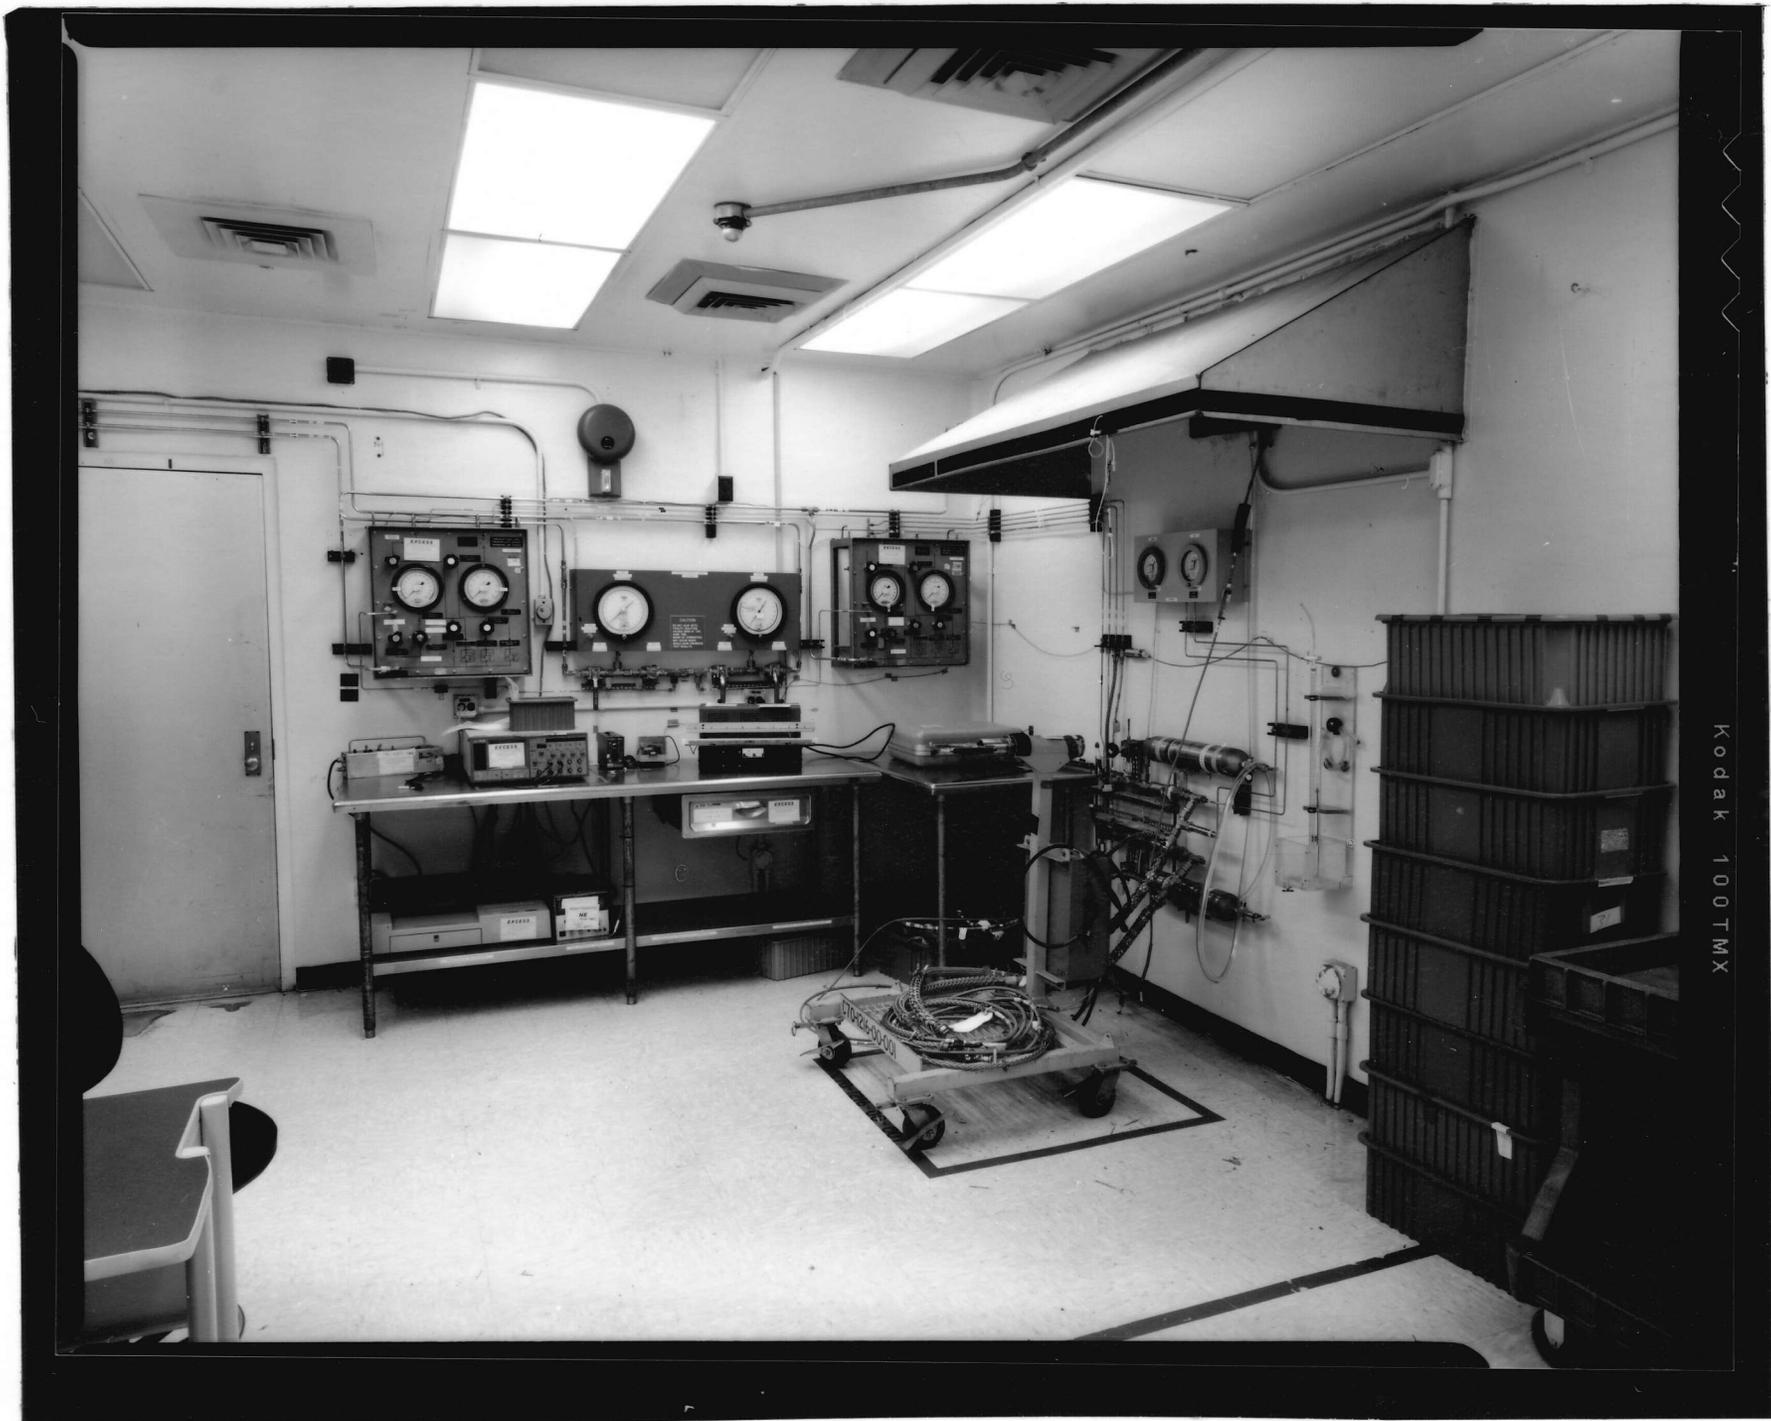

Kodak 100T MX




Kodak 100T MX



KODAK 100T MX



Kodak 100T MX

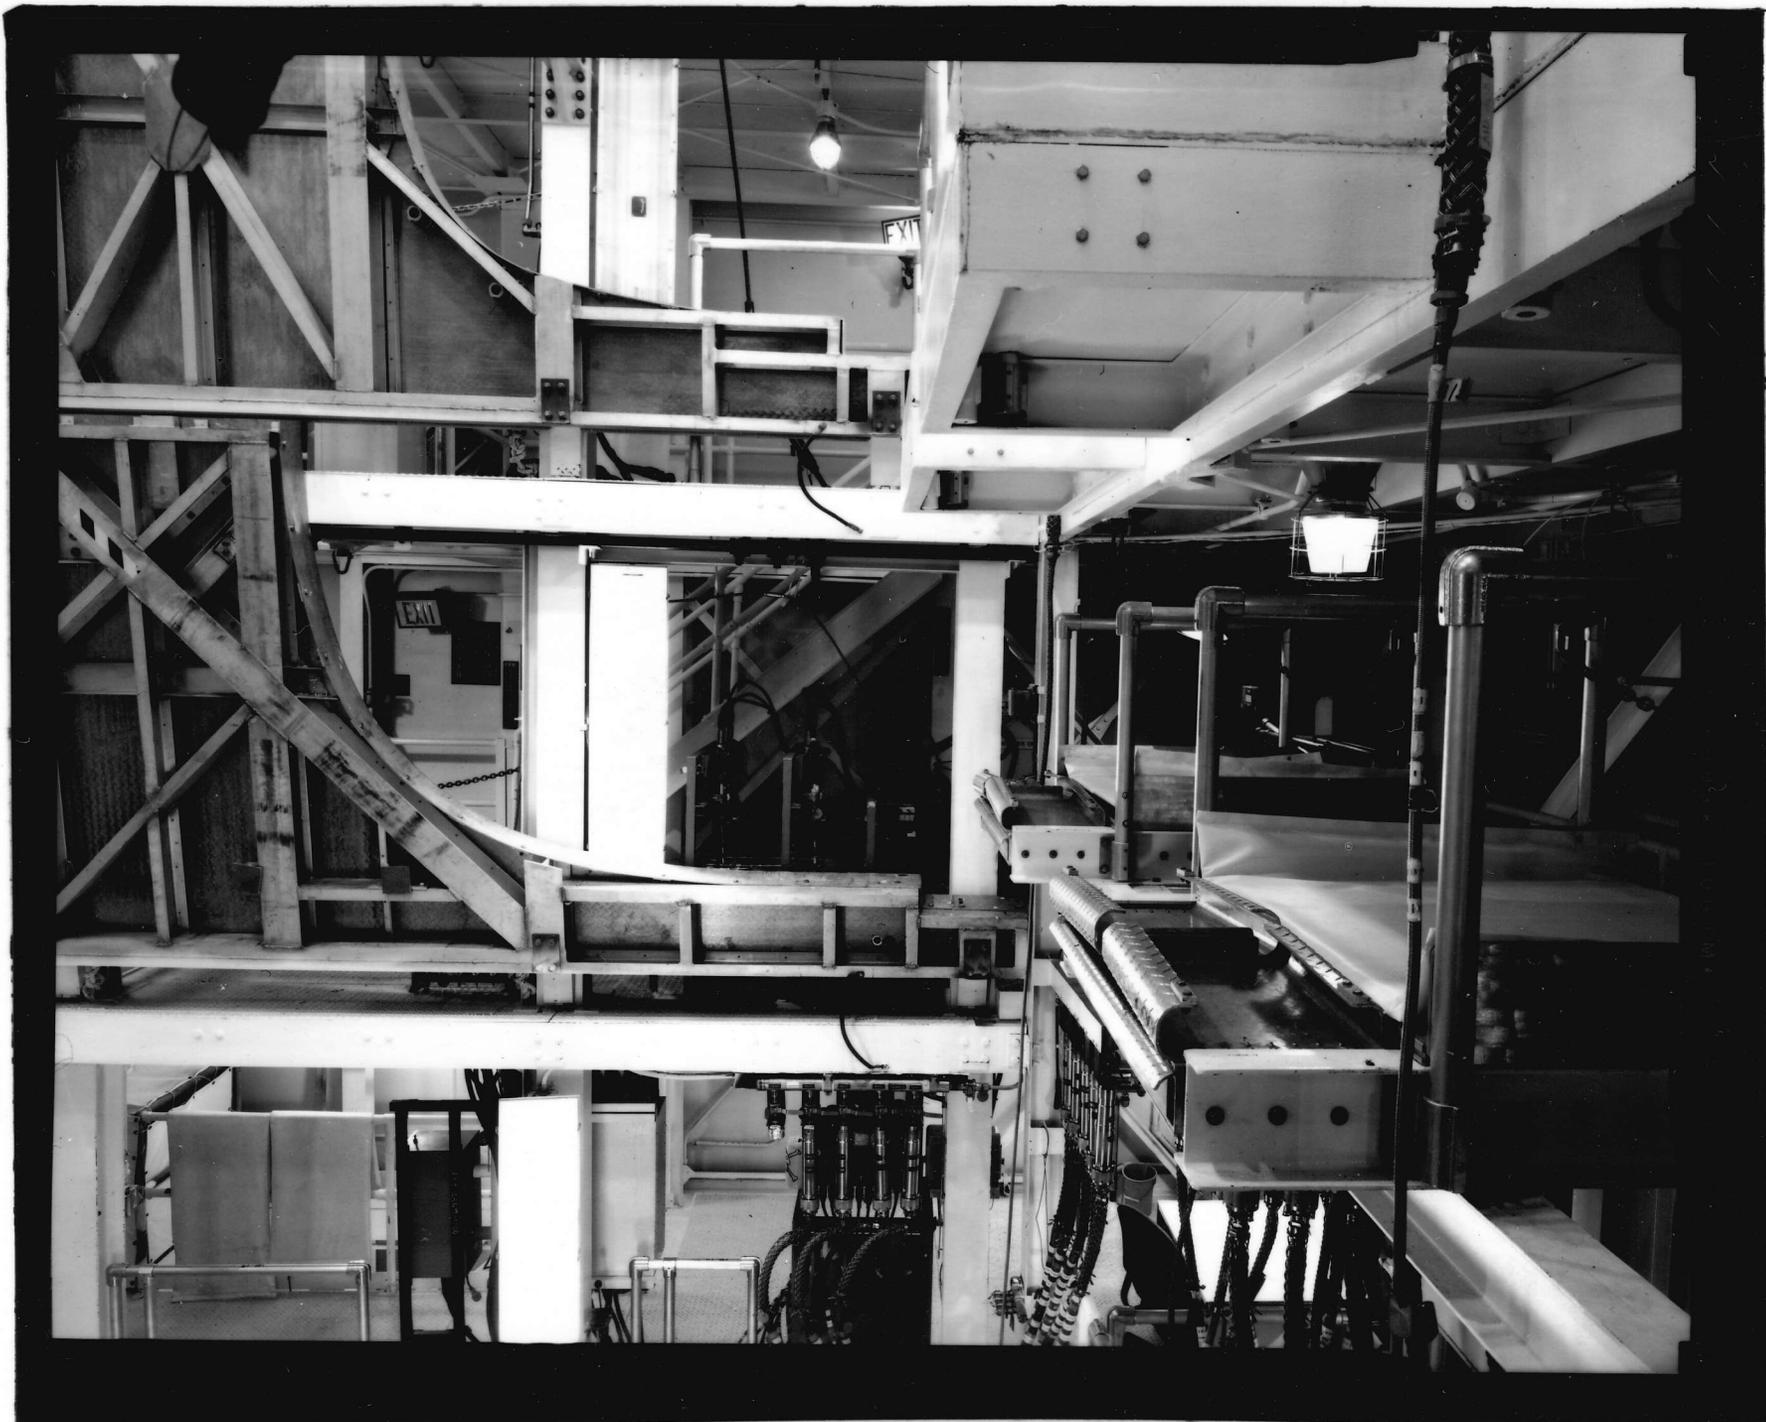




KODAK 100T MX

Kodak 100TMX




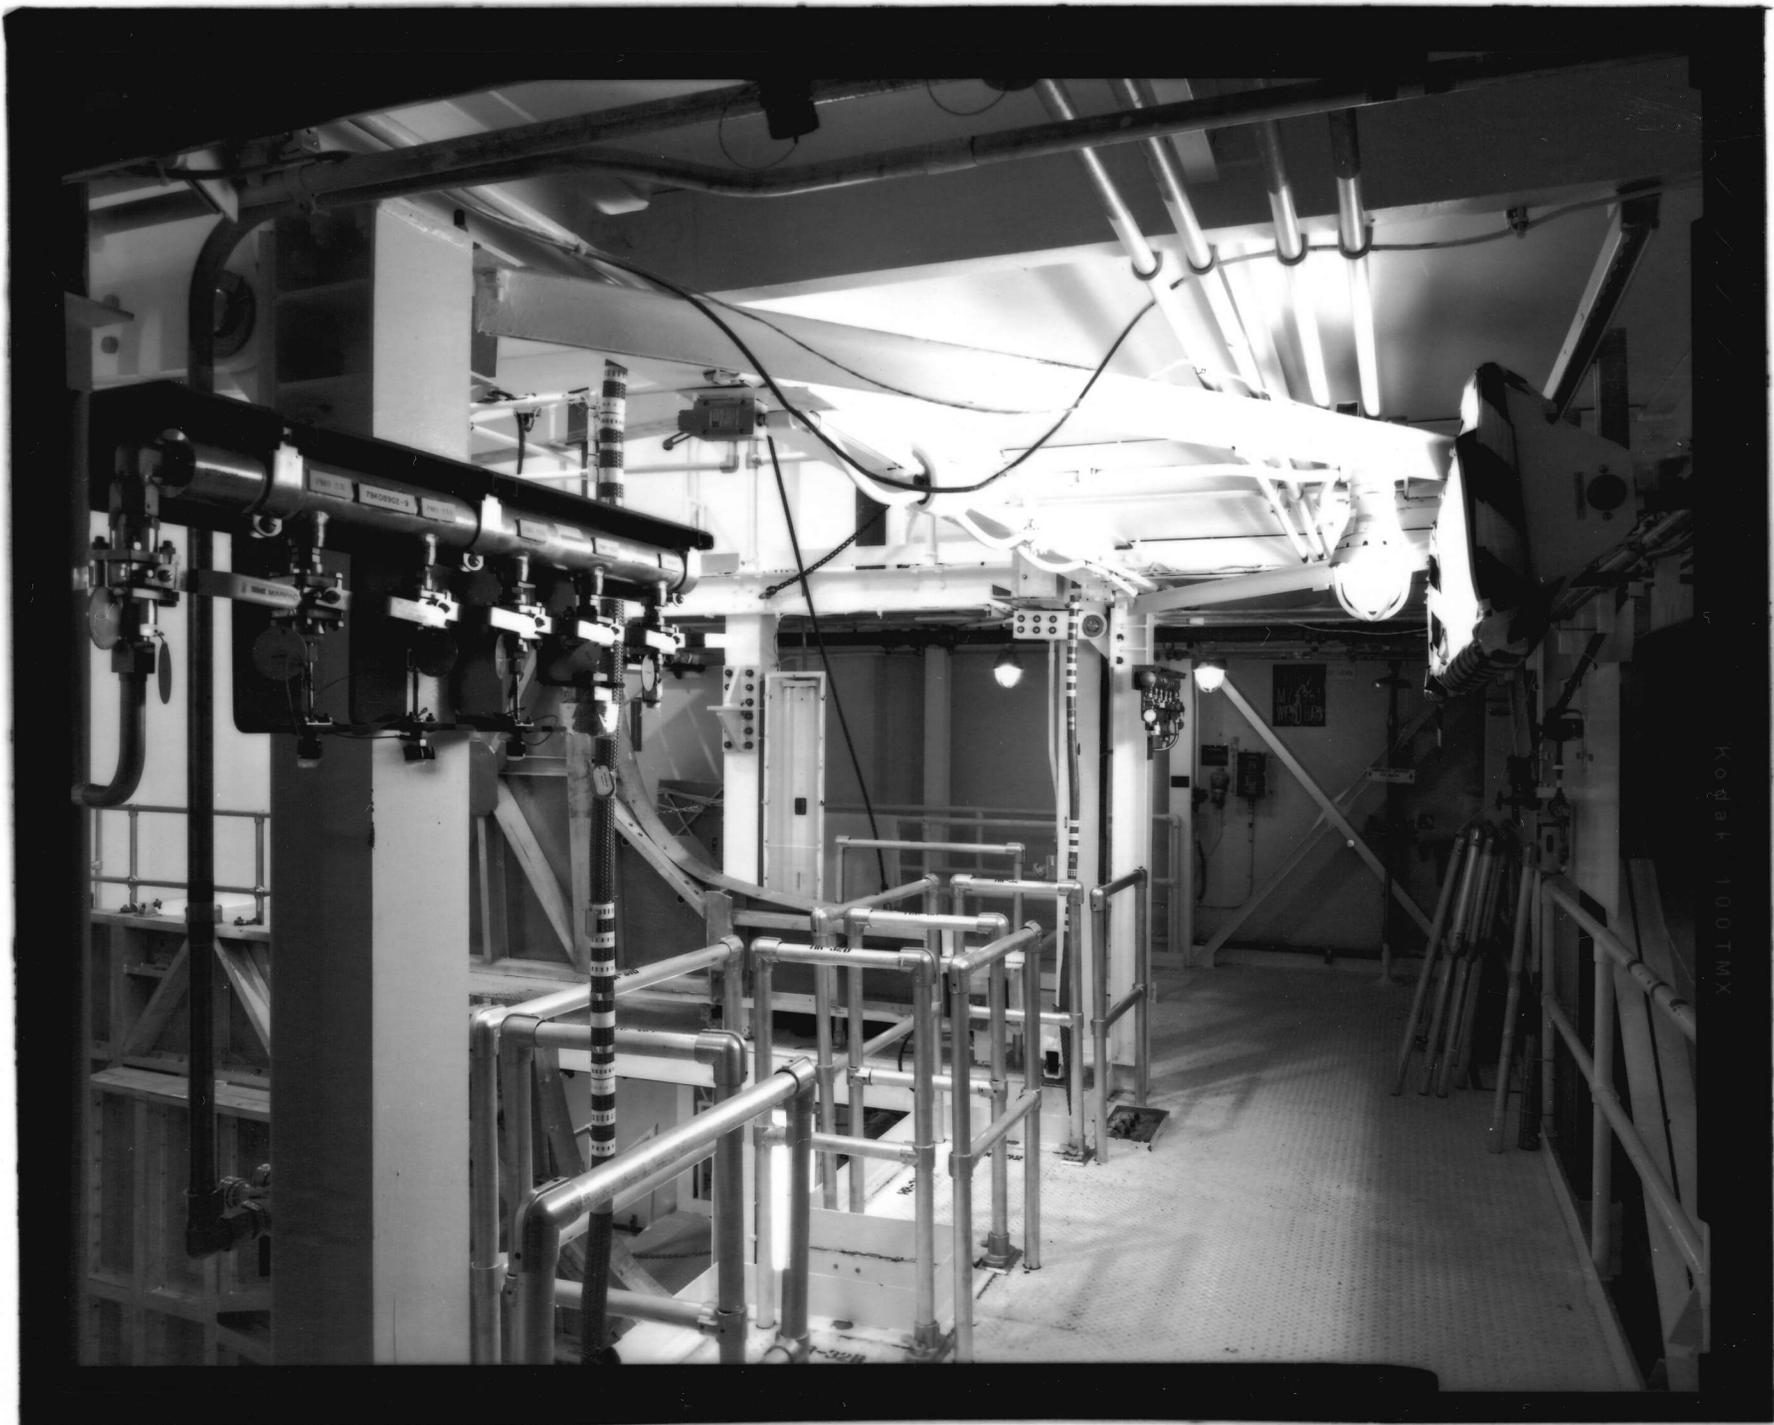

1000T.MX





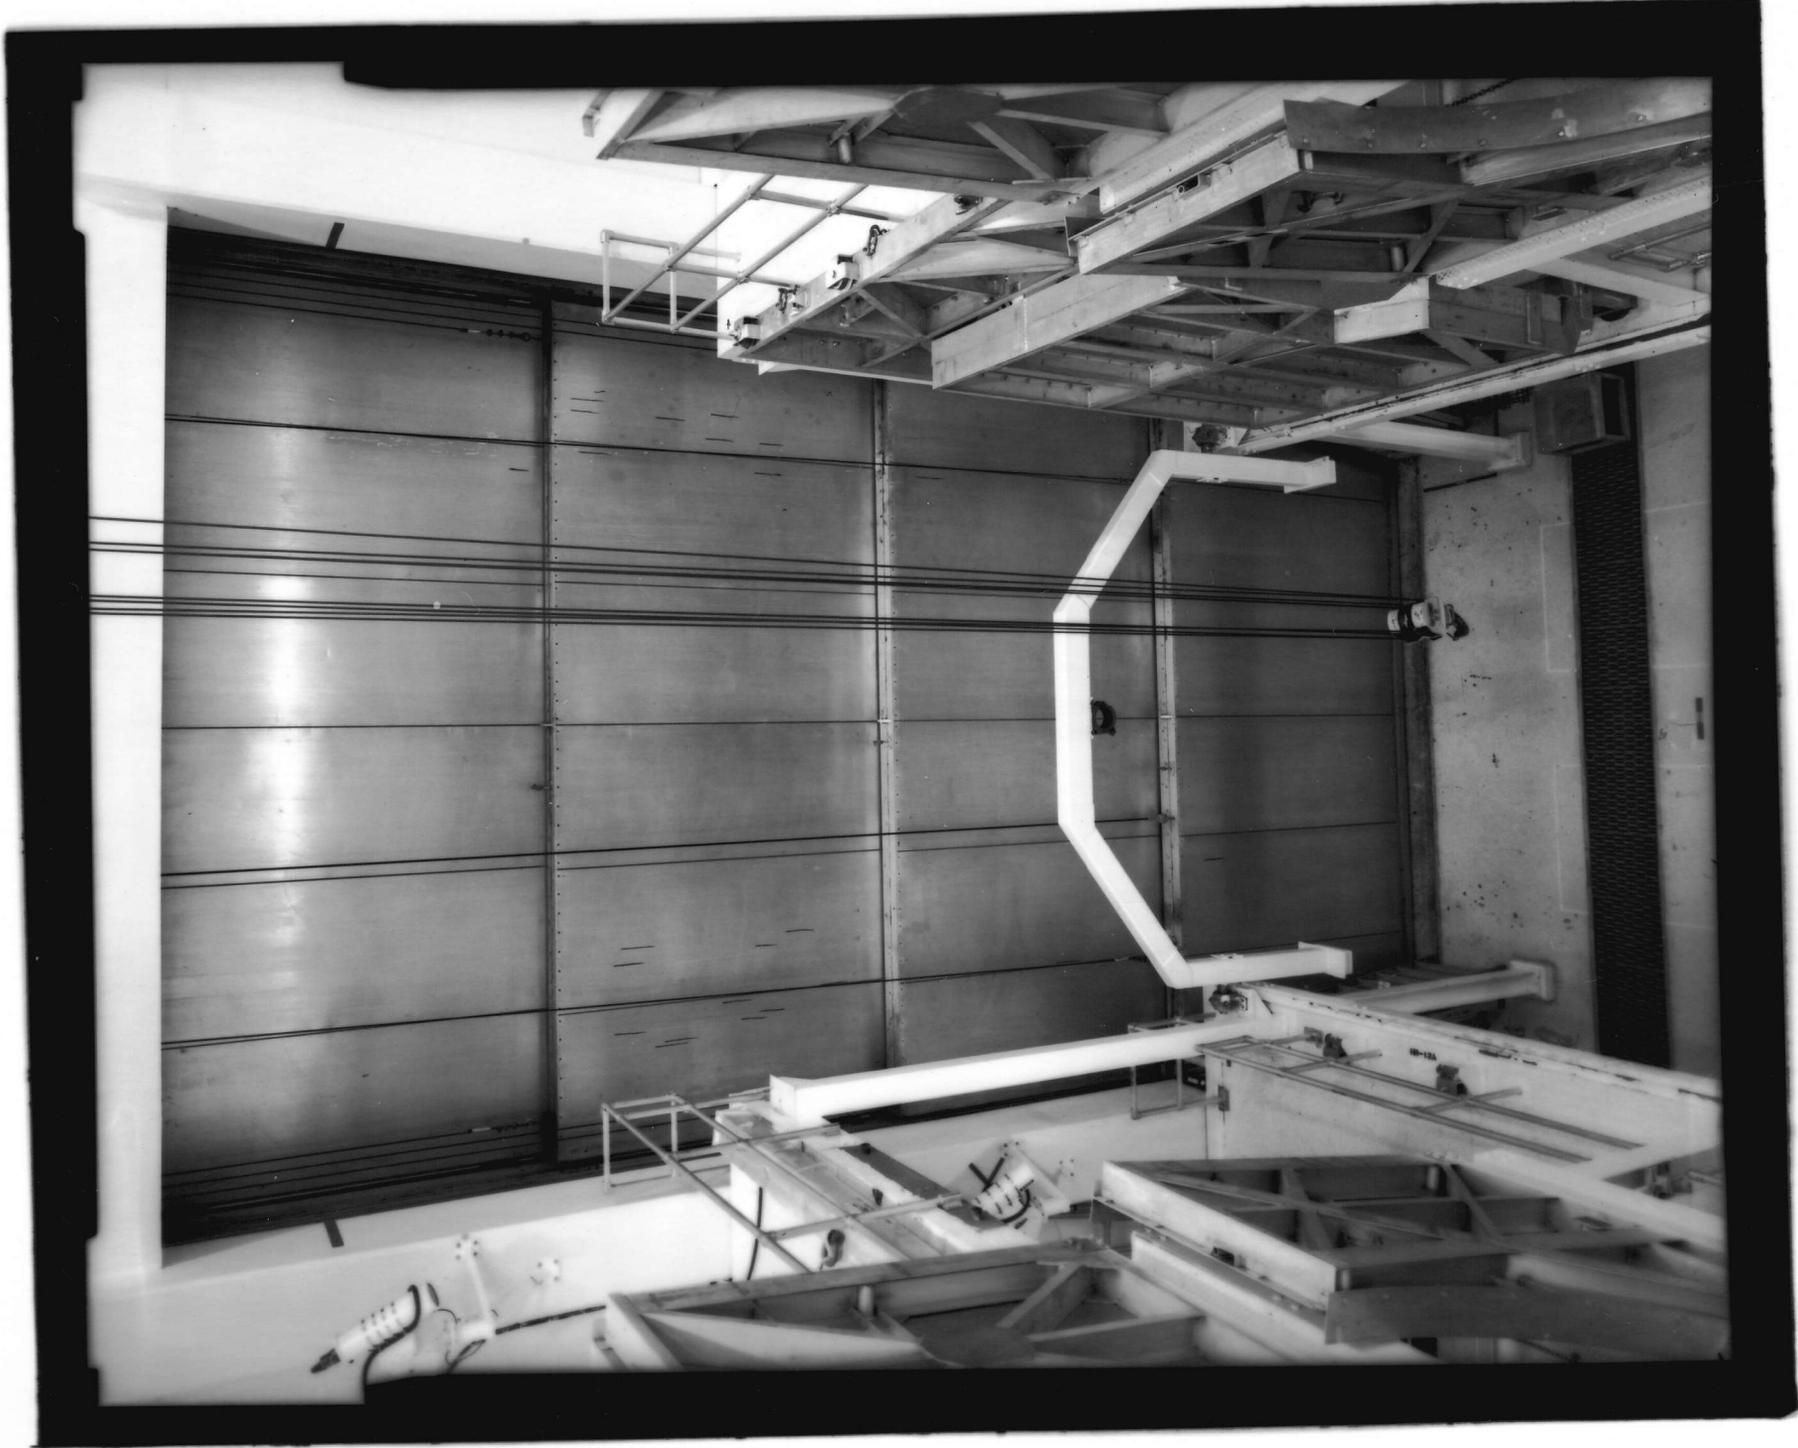





Kodak 100T MX

Kodak 100T MX







100T 011



REVISIONS					
NO.	SYMBOL	ZONE	DESCRIPTION	DATE	APPROVED
15	A	ALL	MOVED DOOR 1, 2, 3, 999, 1000	6-21-63	MM
1	A	ALL	REPLACE DOOR 1, 2, 3, 999, 1000	7/23/63	ZCW
2	B	ALL	MOVED EYE WASH & DECONTAMINATION SHOWER TO OUTSIDE	7/23/63	ZCW
3	B	ALL	ADDED SHOWER IN RESTROOM ROOM TO ACCOMP. MECH. EQ. ROOM	7/23/63	ZCW
4	A	ALL	ADDED SHOWER IN RESTROOM ROOM TO ACCOMP. MECH. EQ. ROOM	7/23/63	ZCW

MATERIAL LEGEND

 CONCRETE BLOCK
 POURED CONC.

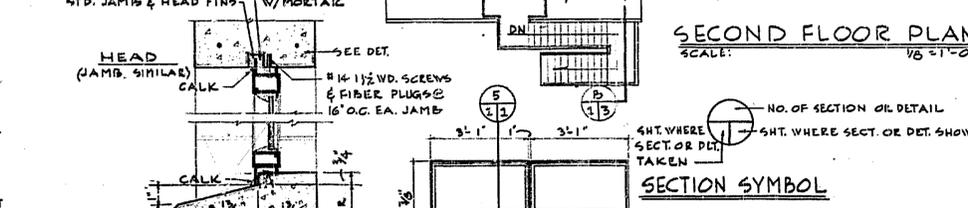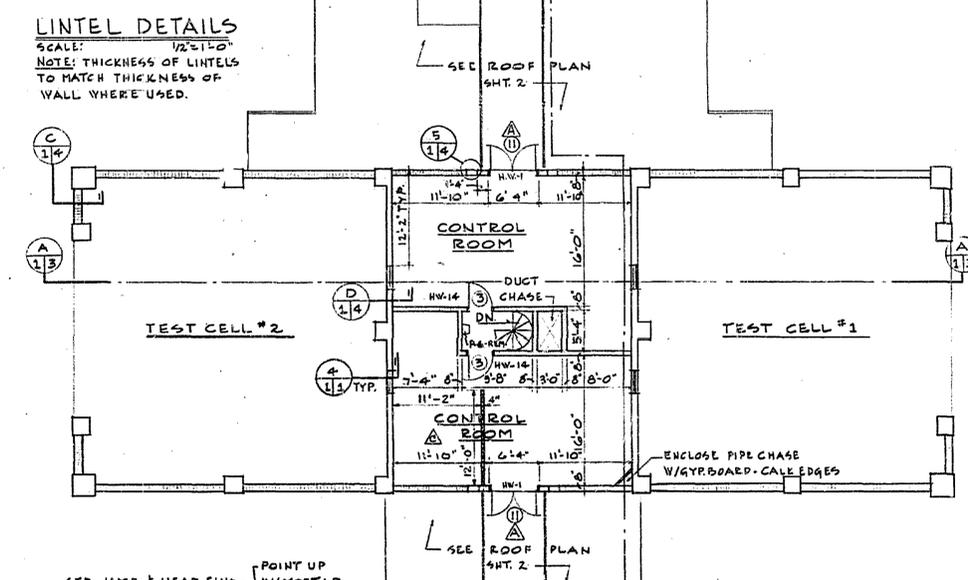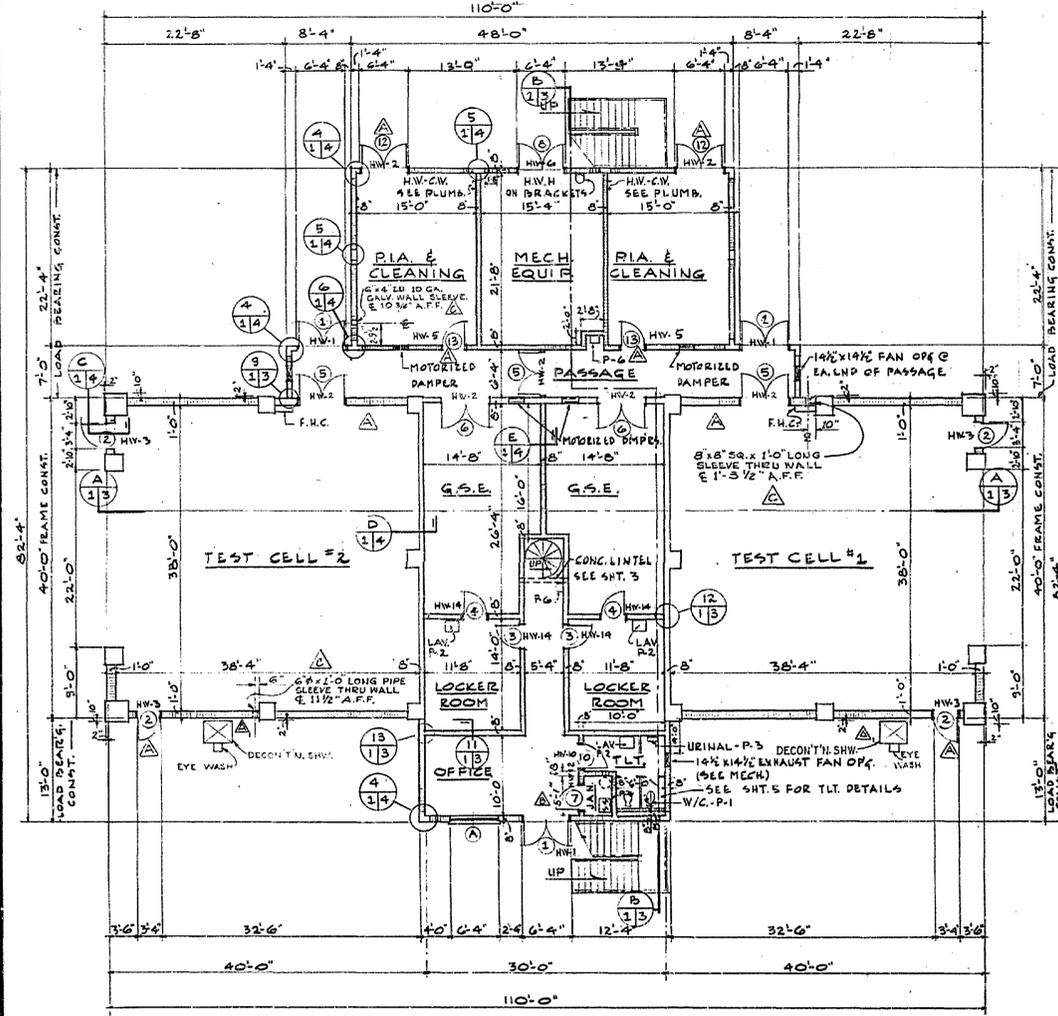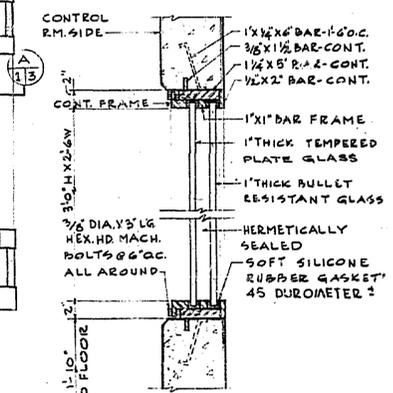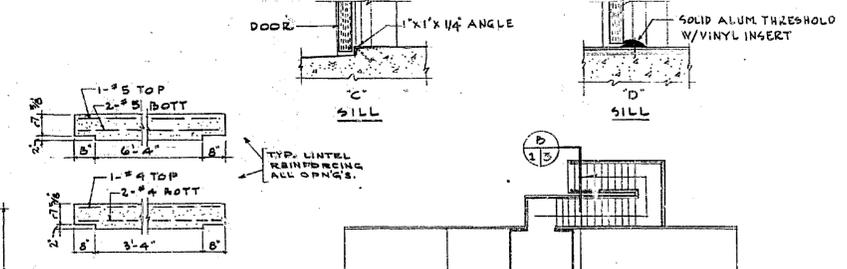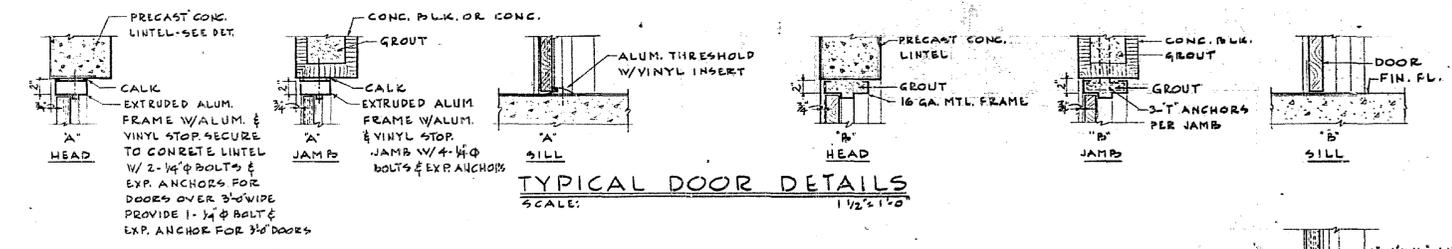

RECORD DRAWING NOTE
 'Shall be,' 'Provide,' 'Install,' 'Remove,' etc. indicates work was accomplished under the contract.

AS BUILT
 APPROVED BY: [Signature]
 DATE: 11 August 1964


ROOM FINISH SCHEDULE

AREA	FLOOR	BASE	WALLS	CEILING	REMARKS
TEST CELL #1 & #2	CONCRETE W/ WAX ROOF TOP		CONC. BLK. & CONC.	GYP. BOARD	SEE SUSPENSION DET.
G.S.E.	VINYL ASB.T.	RUBBER	CONC. BLK. & CONC.	GYP. BOARD	
LOCKER RM'S.	"	"	"	"	"
OFFICE	"	"	CONC. BLK.	ACOUST. TILE	"
TOILET	CERAMIC TILE	CER. TILE	CONC. BLK. & CONC.	GYP. BOARD	SEE DET. & SPEC'S.
RIA & CLEANING	VINYL SHT.	RUBBER	CONC. BLK.	GYP. BOARD	SEE SUSPENSION DET.
PASSAGE	VINYL ASB.T.	"	"	"	"
MECH. EQUIP.	CONC.	"	"	"	NONE SEE PAINT & SPEC.
CONTROL RM'S.	VINYL ASB.T.	RUBBER	CONC. BLK. & CONC.	GYP. BOARD	SEE SUSPENSION DET.
JANITOR	"	"	CONC. BLK.	"	"


DOOR SCHEDULE

NO.	SIZE	TYPE	FRAME	THRESHLD	CLOSER	REMARKS
1	3'-0" x 7'-0"	HOL. ALUM.	TYPE 'A'	TYPE 'A'	YES, EACH LEAF	WEATHERSTRIP
2	3'-0" x 7'-0"	"	"	"	YES, LACTIVE LEAF	"
3	3'-0" x 7'-0"	WOOD, H.C.	TYPE 'B'	"	YES	"
4	3'-0" x 7'-0"	"	"	TYPE 'B'	No	"
5	2'-6" x 7'-0"	HOL. ALUM.	TYPE 'A'	TYPE 'D'	YES, LACTIVE LEAF	WEATHERSTRIP


REVISIONS					
NO.	SYM.	ZONE	DESCRIPTION	DATE	APPROVED
4	(A)	B-2	BLDG. DOWN TO GRD. LEVEL ON NORTH ELEV. (SEE TO BLDG. ADD. TO COM. NASA)	1/14/63	[Signature]
3	(B)		UP-DATED FOR "F.R.D." - ADDED NEW BLDG. ADD.	1/14/63	[Signature]

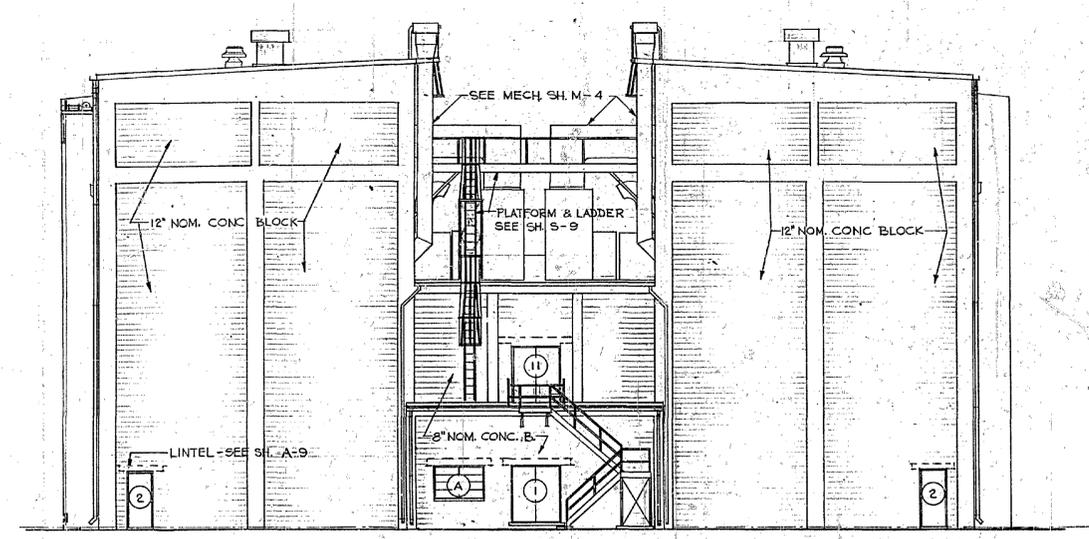


NORTH ELEVATION
1/8" = 1'-0"

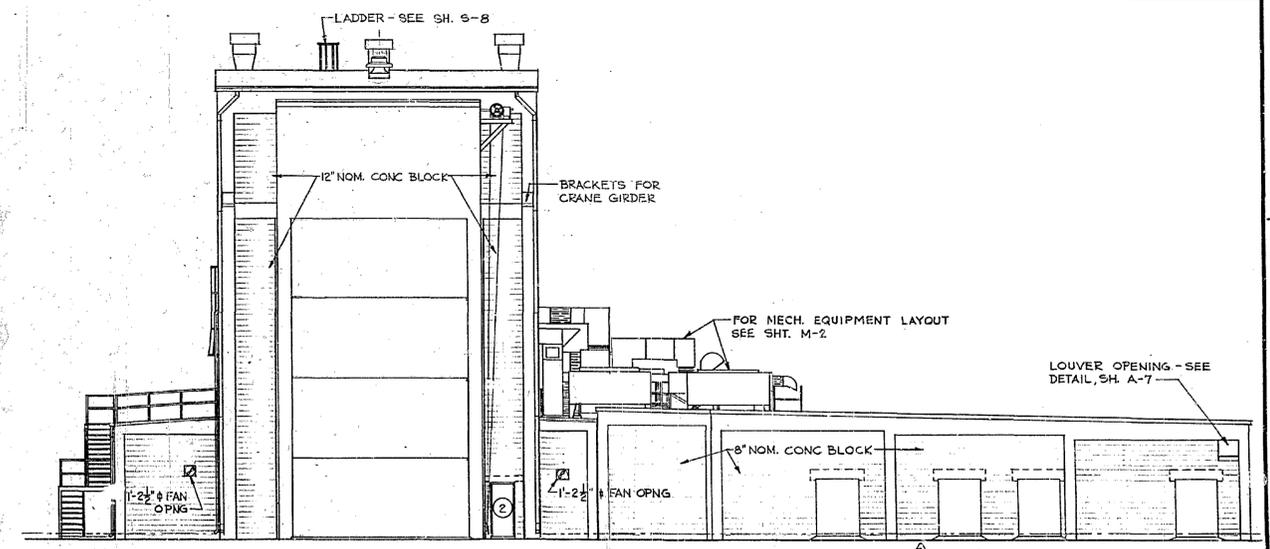


WEST ELEVATION
1/8" = 1'-0"

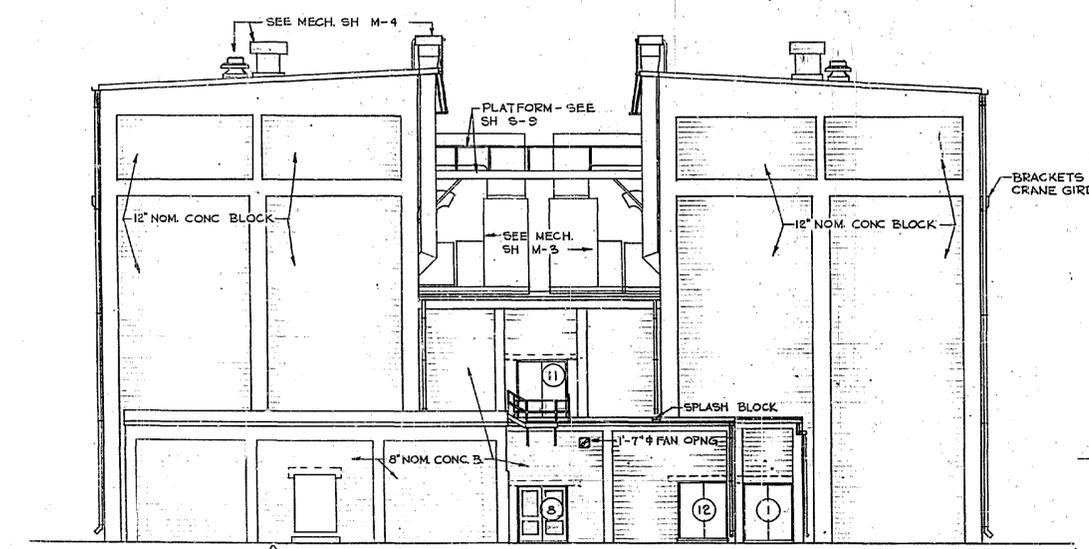


SOUTH ELEVATION
1/8" = 1'-0"

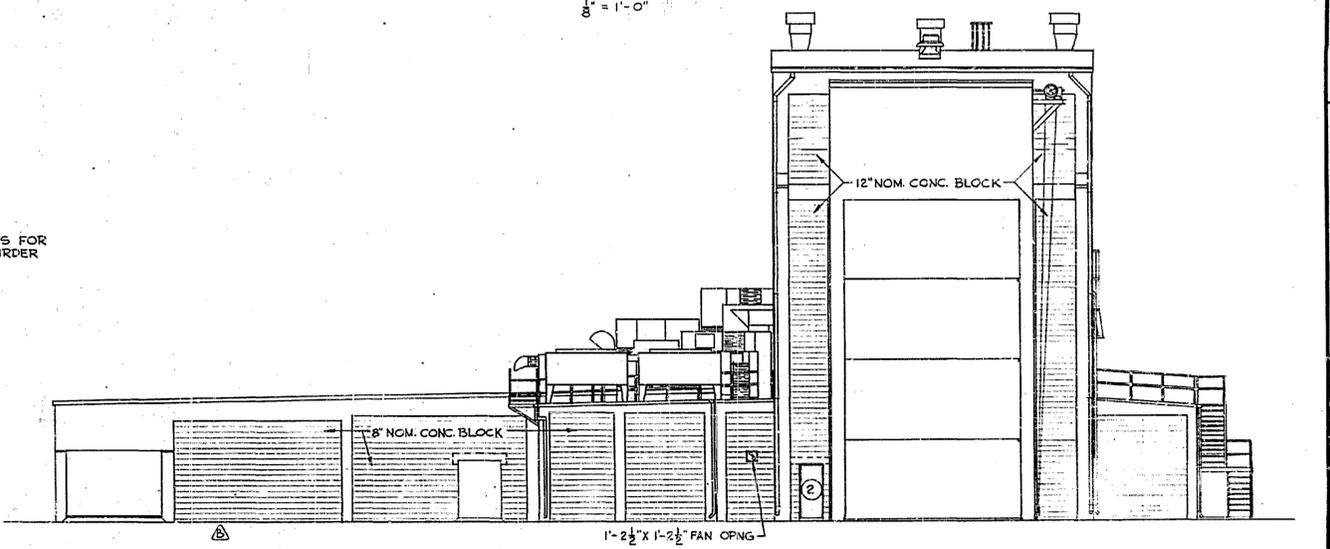

EAST ELEVATION
1/8" = 1'-0"

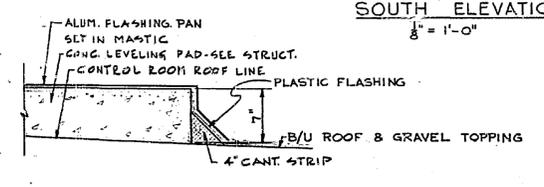


LEVELING PAD DETAIL (FOR ROOF MOUNTED MECH. EQUIP.)
1 1/2" = 1'-0"

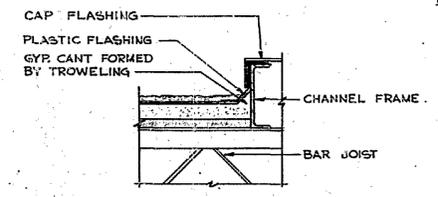

TYP. FAN CURB DETAIL
1 1/2" = 1'-0"

NOTE:
FOR HEIGHTS & OTHER DIMENSIONS
SEE FLOOR PLANS & SECTIONS

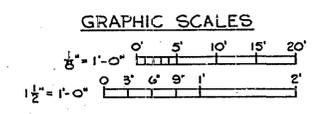





NAASA-KSC
FACILITY RECORD - DRAWING
DRAWING NO. B05.00.000.00200
DATE 11/14/63 APPROVED [Signature]

NATIONAL AERONAUTICS AND SPACE ADMINISTRATION LAUNCH OPERATIONS CENTER	
TAMPA BAY ENGINEERING CO. 191 TREASURE ISLAND CRY. ST. PETERSBURG 4, FLA.	U. S. ARMY ENGINEER DISTRICT, JAX. CORPS OF ENGINEERS JACKSONVILLE, FLA.
NASA MERRITT ISLAND LAUNCH AREA MERRITT ISLAND, FLA. LIFE SUPPORT TEST ARCHITECTURAL ELEVATIONS	
HW. NO. ENG. (MSA) 08-123-43-23 DATED: 5 MARCH 1963 SCALE: AS SHOWN	FILE NO. F 203-22,155 DATED: 2-15-63 SHEET 202 OF









5 4 3 2 1

REVISIONS					
NO.	SYM.	ZONE	DESCRIPTION	DATE	APPROVED
2	A	E-B	ADDED CEILING ACCESS PANELS TO ACCOM. MOD. TO CONTAIN NASA 1010	2/21/63	[Signature]
2	A		ADDED WINDOW SW PARTITION DETAIL TO ACCOM. MOD. TO CONTE. NASA 1010	4/14/63	[Signature]
1	A		UP-DATED FOR "FRD" - ADDED NEW BLDG. ADDITION	1/14/63	[Signature]


E
D
C
B
A

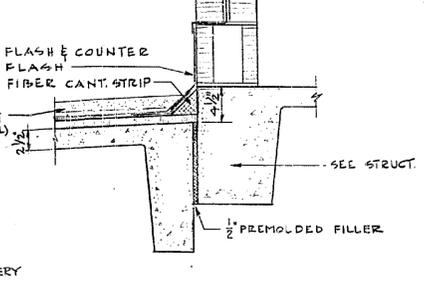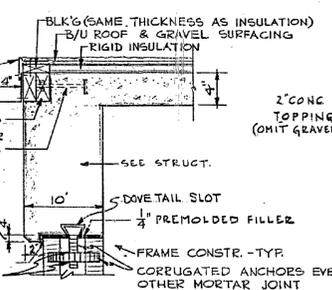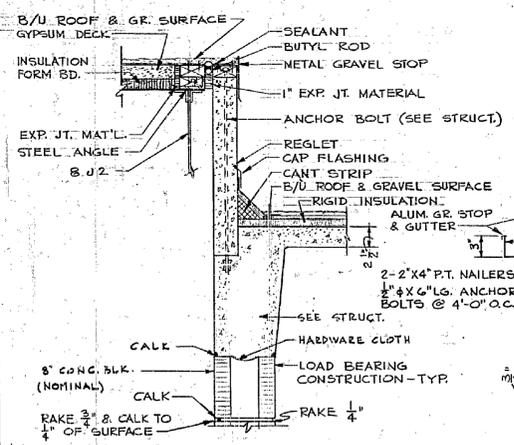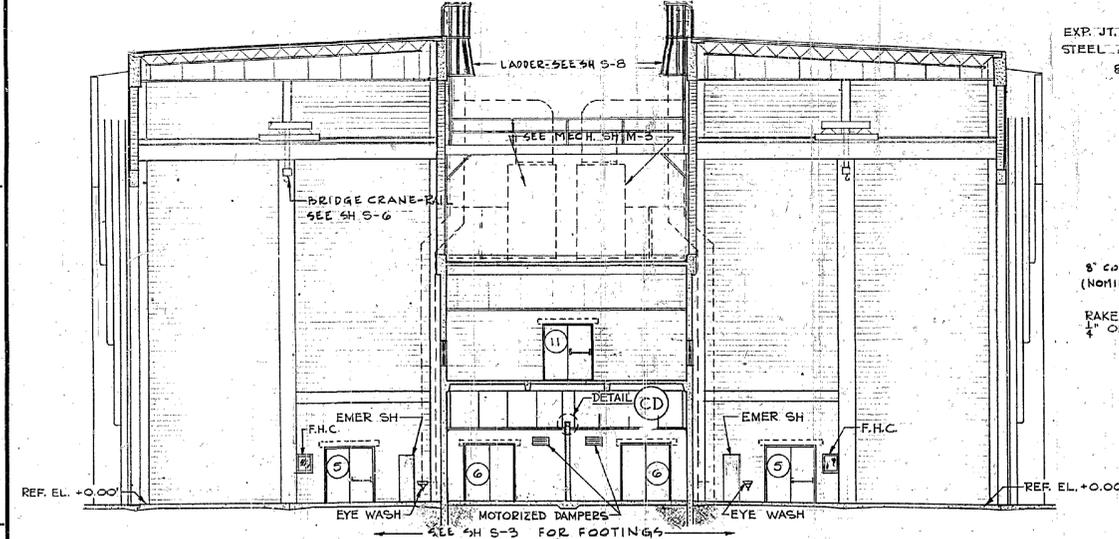

SECTION A
1/2" = 1'-0"

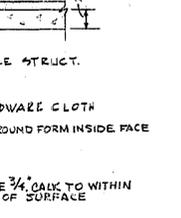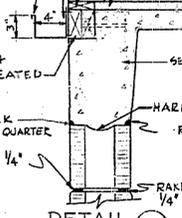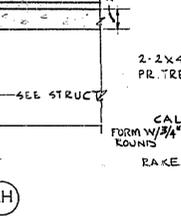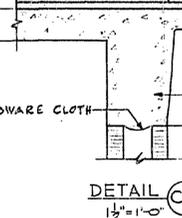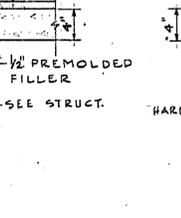
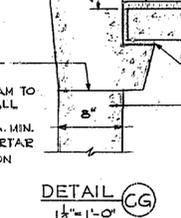
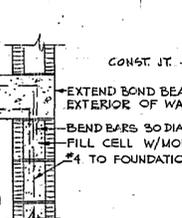
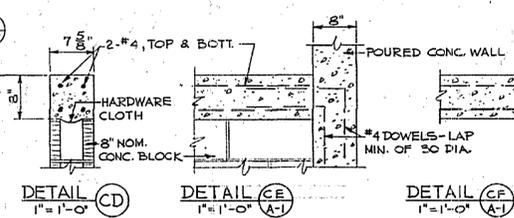


TYP. BOND BEAM @ INTERIOR PARTITIONS


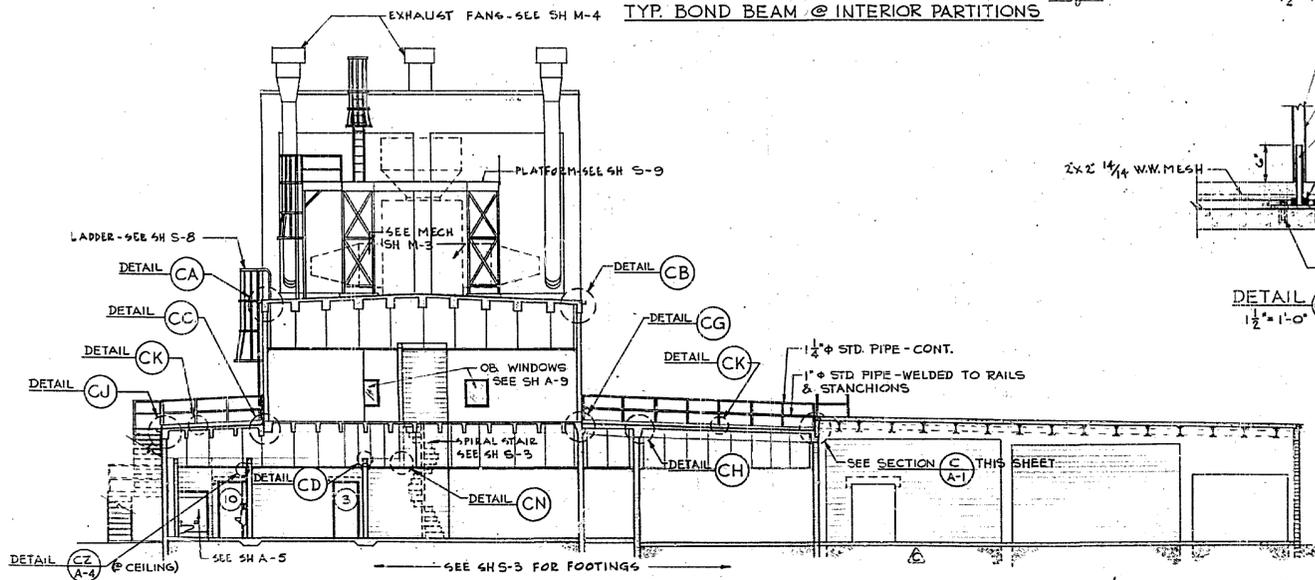


SECTION B
1/2" = 1'-0"

NOTE: FOR HEIGHTS & OTHER DIMENSIONS SEE FLOOR PLANS & SECTIONS

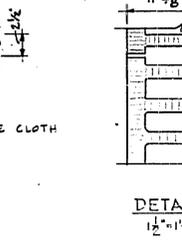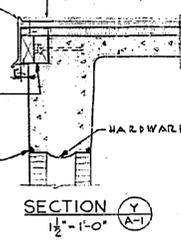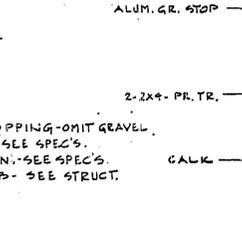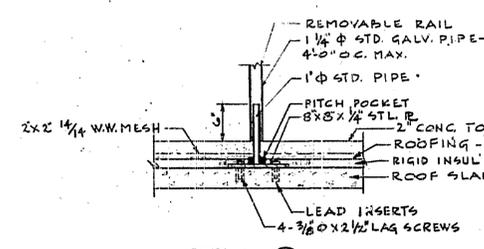

GRAPHIC SCALES

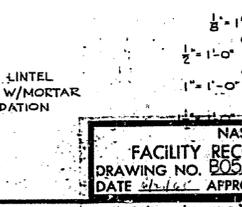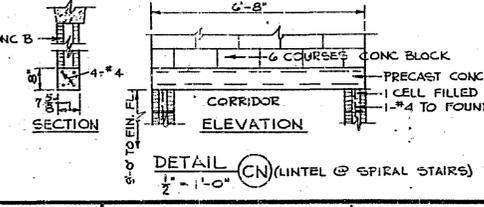

NASA-KSC
FACILITY RECORD DRAWING
DRAWING NO. 805.00.00.00.A03.00
DATE 2/14/63 APPROVED [Signature]

NATIONAL AERONAUTICS AND SPACE ADMINISTRATION
LAUNCH OPERATIONS CENTER

TAMPA BAY ENGINEERING CO.
151 TREASURE ISLAND CRY.
ST. PETERSBURG 4, FLA.

U. S. ARMY ENGINEER DISTRICT, JAL.
CORPS OF ENGINEERS
JACKSONVILLE, FLA.


NASA MERRITT ISLAND LAUNCH AREA
MERRITT ISLAND, FLA.
LIFE SUPPORT TEST
SECTIONS & DETAILS

REV. NO. ENG. 64543 08-123-63-3P
DATE: 5 MARCH 1963
SCALE: AS SHOWN

SIZE: 24x36
FILE NO.: 1203-28,155
DATE: 2-15-63
SHEET: 203 OF

5 4 3 2 1

REVISIONS					
NO.	SYM.	ZONE	DESCRIPTION	DATE	APPROVED
1	△		REVISED TO CONFORM TO AMEND.#4	5/24/65	J.C.H.

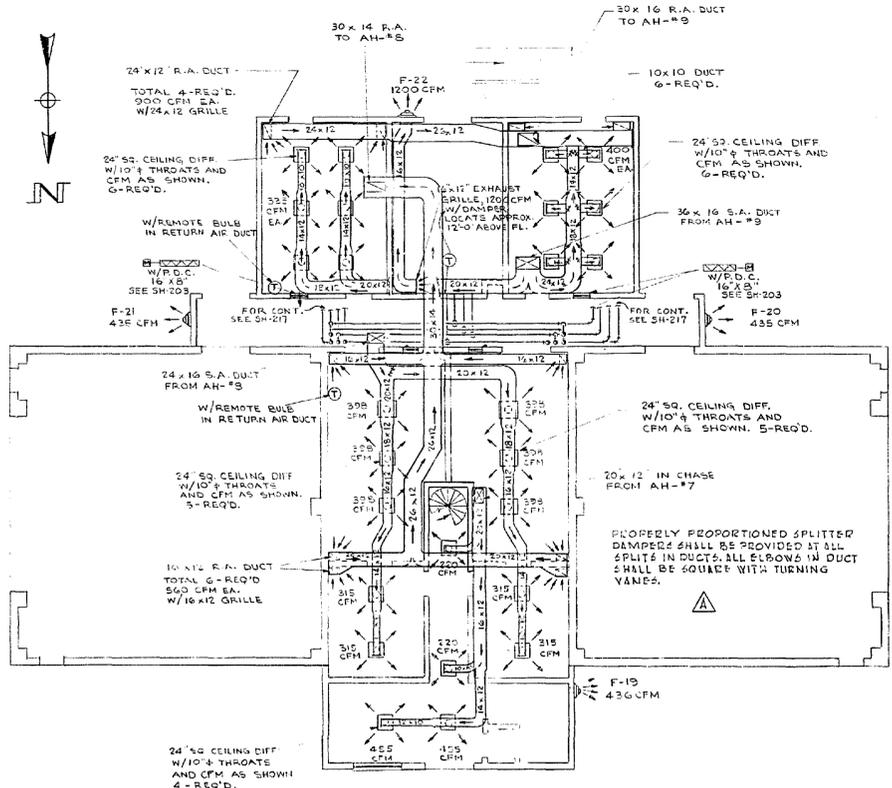

FIRST FLOOR PLAN
SCALE: 1/8"=1'-0"

RECORD DRAWING OF
'shall be,' 'Provide,' 'insert,'
'Remove,' etc. indicates work
was accomplished under the
contract.

NASA BUILD
APPROVED BY: *[Signature]*
DATE: *[Date]*

**NATIONAL AERONAUTICS
AND SPACE ADMINISTRATION
LAUNCH OPERATIONS CENTER**

TAMPA BAY ENGINEERING CO.
151 TREASURE ISLAND CRY.
ST. PETERSBURG 6, FLA.


U.S. ARMY ENGINEER DISTRICT, JACK
CORPS OF ENGINEERS
JACKSONVILLE, FLA.

NASA MERRITT ISLAND LAUNCH AREA
MERRITT ISLAND, FLA.
**FLUID TEST COMPLEX
E.C.S. BUILDING**
AIR CONDITIONING - DUCT L.C. & DET. (FIRST FLOOR)


DATE: 5 MARCH 1965
SCALE: 1/8"=1'-0"
DATE: 2 12 65 SHEET 2100F

SHEET	REFERENCE DWGS.
217	BUILDING PLAN (END FL. & ROOF PLAN)
218	ELEVATIONS
219	FLOW DIAGRAM
220	EQUIP. RM. PLAN AND SECTION


REVISIONS					
NO.	SYM.	ZONE	DESCRIPTION	DATE	APPROVED
3			REVISED SUPPLY AND RETURN DUCTS IN BOTH TEST CELLS	1/15/65	[Signature]
			UP-DATED FOR "FRD"	1/14/65	[Signature]

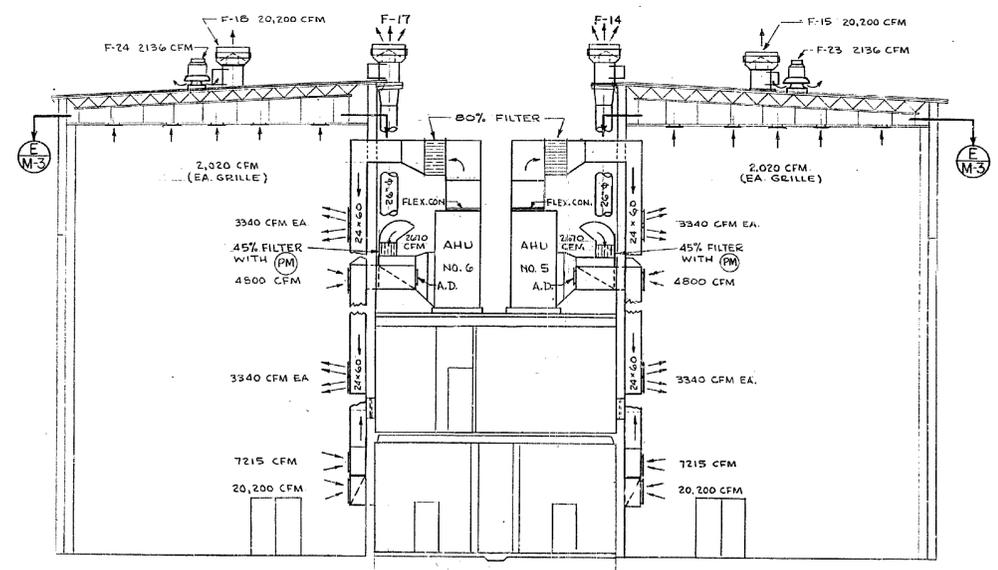


REVISIONS				
NO.	SYM.	DESCRIPTION	DATE	APPROVED
1	Δ	REVISED TO CONFORM TO AMEND #4	5/21/63	J.L.H.
2	Δ	ADDED PARTITION IN CONTROL ROOM TO ACCORD WITH 10 CONTRACT PARA 1.27B	4/11/63	J.L.H.

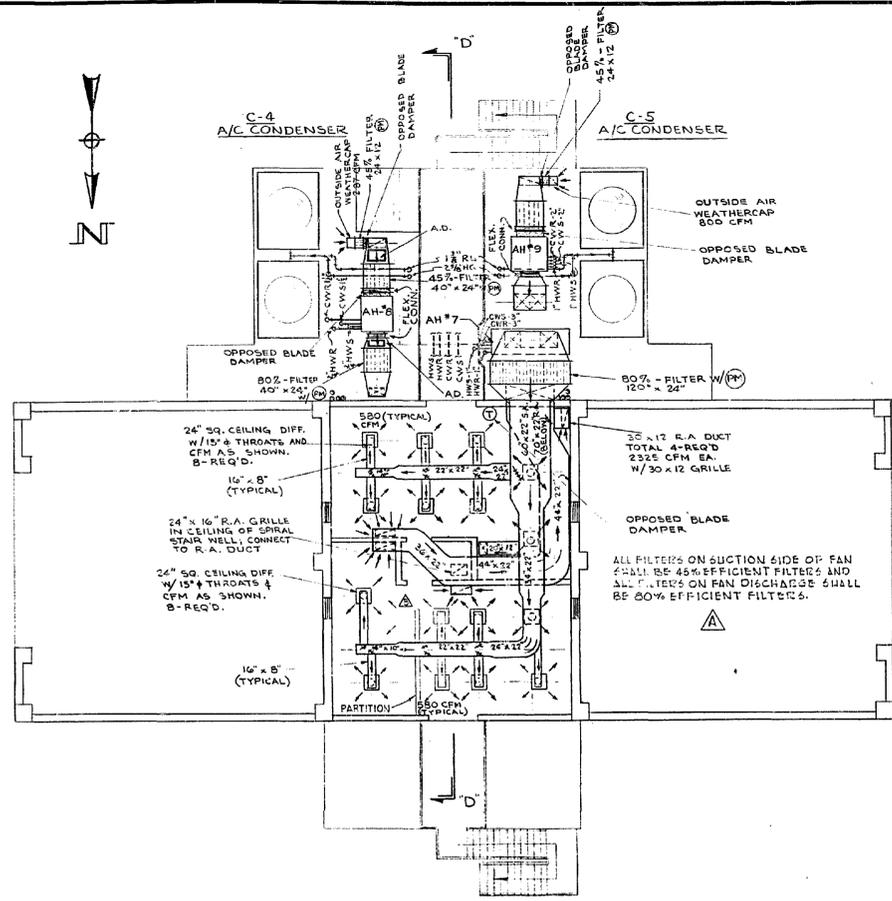

SECOND FLOOR PLAN
SCALE: 1/8" = 1'-0"

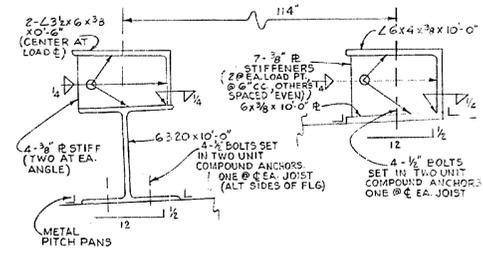


AIR-COOLED CONDENSER SUPPORTS
(TYP - FOUR UNITS, ECS BUILDING)
MSC, FLUID TEST FAC.
SCALE: 3/4" = 1'-0"

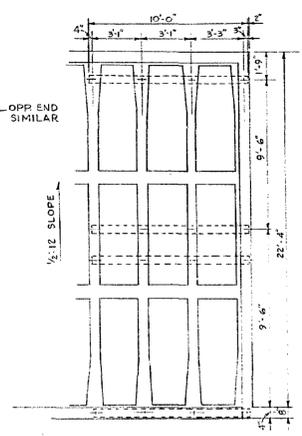


AIR COOLED CONDENSER SUPPORTS
MSC FLUID TEST FAC.
SCALE: 1/2" = 1'-0"

EXHAUST FAN DATA						
UNIT NO.	F-19	F-20, F-21	F-22	F-23, F-24	F-15, 14, 16, 17	F-15, 15
ZONE SERVED	CONTROL OFFICE CORRIDOR (TOILET RM PASSAGE)	P.I.A. LOCKERS	MECH. ROOM	TEST CELLS	TEST CELL FLOOR	TEST CELL CEILING
SIZE, INCHES TYPE UNIT	14.5 SQ	14.5 SQ	19 SQ	19.2 SQ	36 DIA. AXIAL	36 DIA. AXIAL
DRIVE	DIRECT	DIRECT	DIRECT	DIRECT	V-BELT	V-BELT
FAN CAPACITY MAX. CFM (DESIGN)	430	670	1340	2370	20,200	20,200
TOTAL STATIC PRESS. (DESIGN) IN H ₂ O	1/8	1/8	1/8	1/8	1.25	0.5
FAN OUTLET VEL. PPM. (MAXIMUM)	—	—	—	—	2800	2600
FAN SPEED (MAXIMUM) RPM	1100	1650	1140	1140	1155	993
FAN MOTOR H.P. (APPROX.)	1/30	1/10	1/5	1/3	7.5	5.0
MOTOR SPEED RPM	1100	1650	1140	1140	1800/1200	1800
MOTORIZED DAMPER	YES	YES	NO	YES	YES	YES
DIFFERENTIAL PRESS. CONTROL	YES	YES	NO	YES	NO	NO

* BACKDRAFT DAMPER ONLY

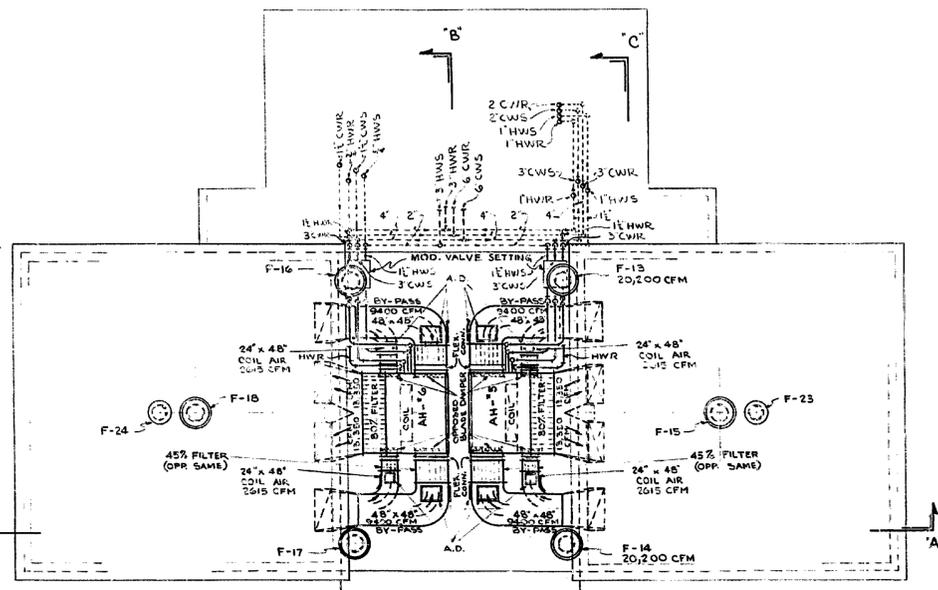

ROOF PLAN
SCALE: 1/8" = 1'-0"

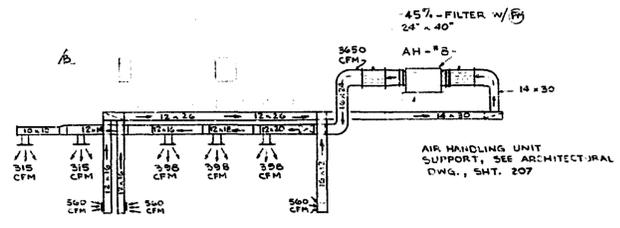

SECTION "D-D"
SCALE: 1/2" = 1'-0"

RECORD DRAWING NOTE
Shall be, Provide, Install, Remove, etc. indicates work was accomplished under the contract.

AS BUILT
APPROVED BY: [Signature]
DATE: 11 August 1963

SHEET	REFERENCE DWG'S
216	BUILDING PLAN (1ST FL.)
217	BUILDING PLAN (2ND FL. & RF PLAN)
218	ELEVATIONS
219	FLOW DIAGRAM
220	EQUIP. RM. PLAN & SECTIONS

NATIONAL AERONAUTICS AND SPACE ADMINISTRATION
LAUNCH OPERATIONS CENTER

TAMPA BAY ENGINEERING CO.
151 TREASURE ISLAND CRY.
ST. PETERSBURG 6, FLA.

U. S. ARMY ENGINEER DISTRICT, ILL.
CORPS OF ENGINEERS
JACKSONVILLE, FLA.

NASA MERRITT ISLAND LAUNCH AREA
MERRITT ISLAND, FLA.

FLUID TEST COMPLEX
ENVIRONMENTAL CONT. SYST'S BLD'G
HEATING, VENTILATING & AIR COND.
SECOND FLOOR & ROOF PLAN

REV. FILE NO. 203-28,155
DATE: 5 MARCH 1963
SCALE: AS SHOWN DATE: 2-15-63 SHEET 217 OF